

RENEW 1716 T L & S ROW

FOUND - ORIG. 18" NOW 52" B. OAK
N 62° E 47.6' PREVIOUSLY OPENED
OLD FENCE ROTTEN. WE ALSO FIND
1" UP AT COR # NOW 52" B. OAK
S 13° E 132' SHOWS GOOD SCAR
WE DO NOT OPEN

NOTE - E W FENCE 12' NORTH


NEW BTS.
DESCRIBE NOW 52" B. OAK
N 69° E 37.5' S 16 TRES ROW CSBT
12' B. OAK BEARS S 17° W 54.8'
SCRIBED 320 TRES ROW CSBT

NO TREES NEAR TO N W

NO ✓

RENEW 1/4 COR. 1716 TRES ROW

FOUND - POINTED ROCK AT COR
6" ABOVE GR. ALSO FIND NOW
B. OAK N 78° W 30' SHOWS
GOOD SCARS, RECORDED BY FRENCH
FENCE COR TIES

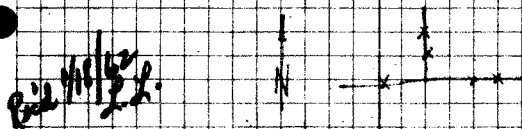

SET BRASS CAP ALONGSIDE COR.
STONE & MARKED. COUNTY SURVEYORS
OFFICE 1962 1/4 S 17° 16 TRES ROW

NEW BT
S W. OAK BEARS N 51° E 13'
SCRIBED 1/4 S 16 CSBT

JAN 18 - 1962 CS. PLO. NO. 49/392

NO ✓ U. B. U. M. VAR 20 ±

DIETZEN NO. 385-6