

RENEW CC 24 | T295

25 | RW RW

FOUND - COR. STONE WITH "C"

CHISELED ON FACE. WE FIND COR. STONE AT BASE OF FENCE COR.

POST AND OUT OF GROUND. WE DO

NOT FIND NW BT THIS AREA IN

YARD. WE CHECK RECORD BEARING

52° W (SEE BBT SURVEY) RECORD

DIST TO SEC. COR  $\frac{119}{130}$


SET BRASS CAP AT FENCE COR.

MARK CC 324 | T295  
525

RW RW

COUNTY SURVEYORS OFFICE 1962

FENCE THIS ROAD

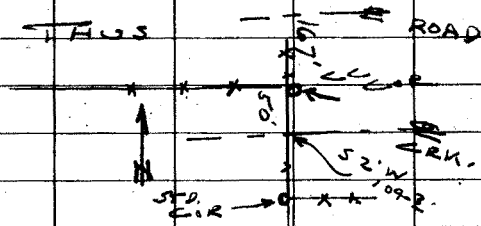

NEW BT

94 MAPLE BEARS S 64° W 22.6'

SCRIBED CC 525 CS BT

*[Handwritten scribbles and signatures]*