

RENEW SE $\frac{1}{4}$ S 19 T 25S R 6W

FOUND - SCRIBED STAKE AT COR
8' WEST OF ROAD & IN E-W FENCE LINE
WE FIND 3 6" R. FIR BEARS S 68° W 22'


BARK SCRIBED CS $\frac{1}{6}$ S THIS BT
NOW DEAD.

SET $\frac{3}{4}$ " IR, ALONGSIDE SCRIBED
STAKE FIR $\frac{1}{6}$ COR

NEW BT

8" R. FIR BEARS N 51° W 28'

SCRIBED $\frac{1}{4}$ S 19 CS BT

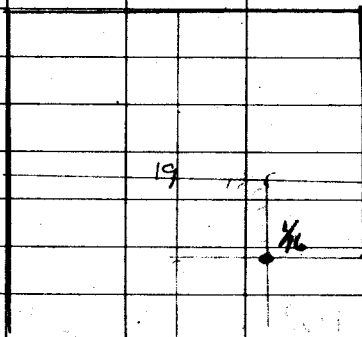

Renewed in May 1917 by Frank

See F.B. 11, Pg. 337 - Vol. 3, Pg. 390

+ * ✓

4/1962

CS 491139 - 37