

RENEW ^{10/11} 15/14 T295 R6W


FOUND - 1" I.P. AT COR & ALSO

BTS AS RECORDED BY FREAR 1918

SE. & SW BTS NOW STUMPS SHOW

GOOD SCARS NE. BT NOW DOWN &
WE OPEN SE BT &
PARTLY ROTTED FIND GOOD SCRIBING
'BT'

FENCE COR THUS

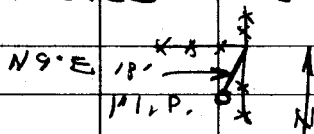

NEW BTS.

13" R. FIR BEARS S 25° E. 40 1'

SCRIBED S 14 T 295 R 6W CS BT

10" LAUREL BEARS S 56° W 39 9' SCRIBED

S 15 T 295 R 6W CS BT

10" R. FIR BEARS N 9° E 14.5'

SCRIBED S 11' CS BT

MAR. 20 1/2

APRIL 16 - 1962

D. B.

D. M.

J. P.

RENEW

+* ✓

CS 49/139-43