


RENEW $\frac{1}{4}$ COR. 28 T 29S R 7W
33

FOUND - BRASS CAP AT CORNER
BOTH BTS NOW STAMPS SEE BT
SHOWS GOOD SCRIBING "BT"

NEW BTS
9" CEDAR BEARS N 47° E 65.9'
SCRIBED $\frac{1}{4}$ S 28 CS BT
11" P. FIR BEARS S 76° W 62.4'
SCRIBED $\frac{1}{4}$ S 33 CS BT

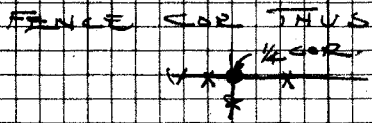

* * O ✓

RENEW 28/27 T 29S R 7W
33/32

FOUND - BRASS CAP AT COR. N E $\frac{1}{4}$
NW BTS OK RECORDED 1954 SURVEY
I DESCRIBE NOW 24" LAUREL
S 80° W 33.8' S 33 T 29S R 7W CS BT
AND REDESCRIBE NOW 26" LAUREL
S 46° E 15.2' S 32 T 29S R 7W CS BT

FILED

RECEIVED

VAR. 20 1/2'

MAY 17 - 62

S. B.
D. R.
U. P.

MAY 17 1962

COUNTY SURVEYOR
GLAS COUNTY, ORE.

* * O ✓

C. S. File No. 49/139-40

DIETZEN NO. 385-6