

RENEW INT. COR. DLC 52
AND SE COR. DLC 49 T285 R6W


FOUND - BRASS CAP AT COR., 2"
UNDER SURFACE.

NO TRACE OF NW BT FOUND.

SW OK SHOULD BE 562' W 3006'
NOT 542' W 3006'

NEW BT.

20" B. OAK BEARS N 19' E 2006'
SCRIBED SE DLC 49 CS BT

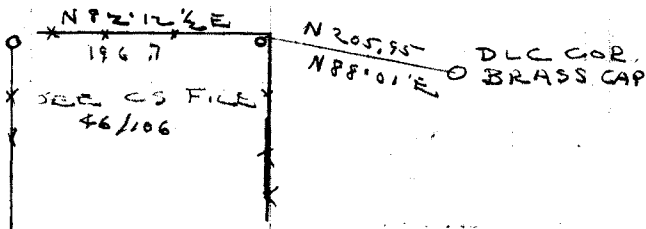

Nov. 15 - 1962

J. B.
M. D.
D. S.

G.S. File No. 49/139-97