


RENEW SE DLC 51 T 305 R6W

FOUND - BOTH BTS AS RECORDED
BY WENDROTH 1966. BTS ARE TO
BE REMOVED BY P&EC AT THIS
TIME. WE ALSO FIND PK NAIL
IN PAVING AT COR.

NEW BT
12" W. OAK BEARS 542' W 2135
SCRIBED SE DLC 51 C 5 BT
11" I.R. BEARS SOUTH 422'

ROAD TIES

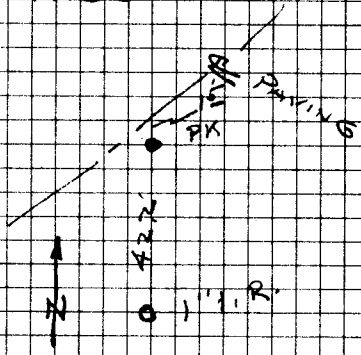

JUNE 4 - 1963

J. B.
M. D.
B. S.

DIETZGEN NO. 388-6

C. S. File No. 49/139-103