

RENEW 27126 T 29 S R 5 W
24 35


FOUND - 5" + ON ROCK S 74° W
61' SOUTH EAST COR. FOUND -
ATION. IN 36° W 109 L'. WE FIND
STUMP OF NE BT SHOWS SCRIBING
3/4" I.R. AT COR. NOT FOUND. 3/4"
I.R. S 78° 50' E 109.7' NOT FOUND.

SET BRASS CAP AT CORNER
MND COUNTY SURVEYORS OFFICE
1963 5271526 T 29 S R 5 W
534/535

NEW BT,

20" W. OAK BEAMS S 71° E 124°
SCRIBED S 35 T 29 S R 5 W CS BT

NOTE - SET 3/4" I.R. AT
FRONT COR. T 29 S R 5 W. N 52° E 1760'

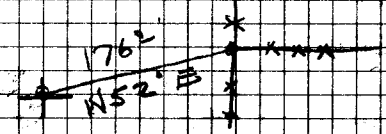

JUSTICE 7-1963
J. B. VAR 20 1/2
M. D.
B. S.

DIETZGEN NO. 388-6

O
+ X ✓

C. S. File No. 49/139-105