

Review $\frac{1}{4}$ COR. of. $\frac{513}{524}$ T295 R6W

Ed. 1" I.P. & BRASS Cap MKd. "County
SURVEYOR'S Office 1957 T295 R6W
 $\frac{1}{4}$ S $\frac{13}{24}$ " & B.T. STUMP as Recorded
in Renewal # 128-

40" Fir STUMP N. 8° E. 24 $\frac{2}{3}$ ft.

New B.T's —

14" Maple N. 13° E. 43° ft.

Mkd. $\frac{1}{4}$ S 13 CS BT

12" Maple S. 19° E. 72 $\frac{1}{2}$ ft.

Mkd. $\frac{1}{4}$ S 24 CS BT

This COR. Lies on W. Edge of
CAT Road approx. 75° ft. West of
Small Creek.

August 21, 1964

V.R.T.
M.D.
J.B.

V.R. Tracy

FILED

RECEIVED

AUG 21 1964

COUNTY SURVEYOR
DOUGLAS COUNTY, ORE.


C. S. File No.

49


139-111

T 29 S R 6 W

~~Map~~ #128

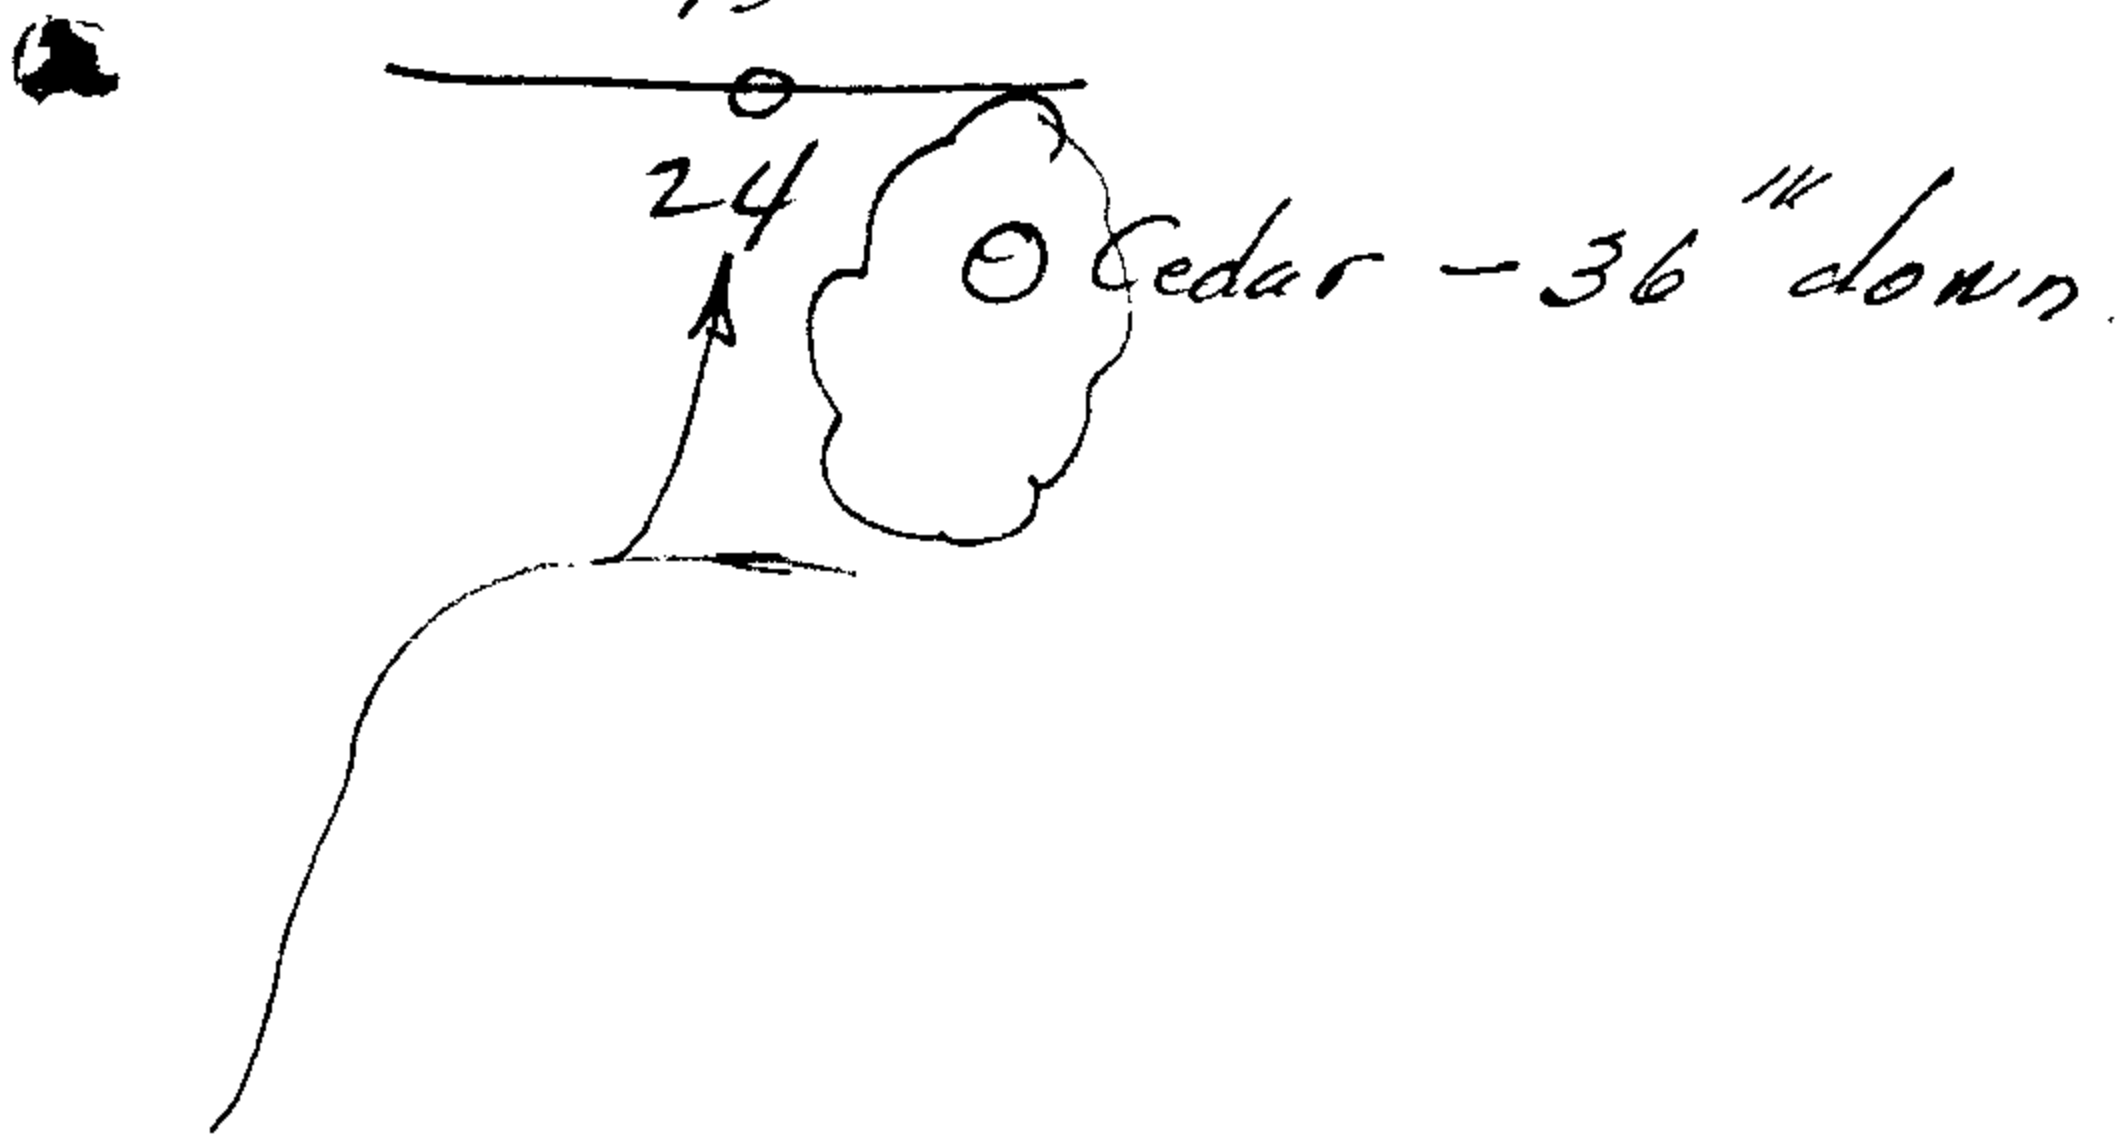

24 #130

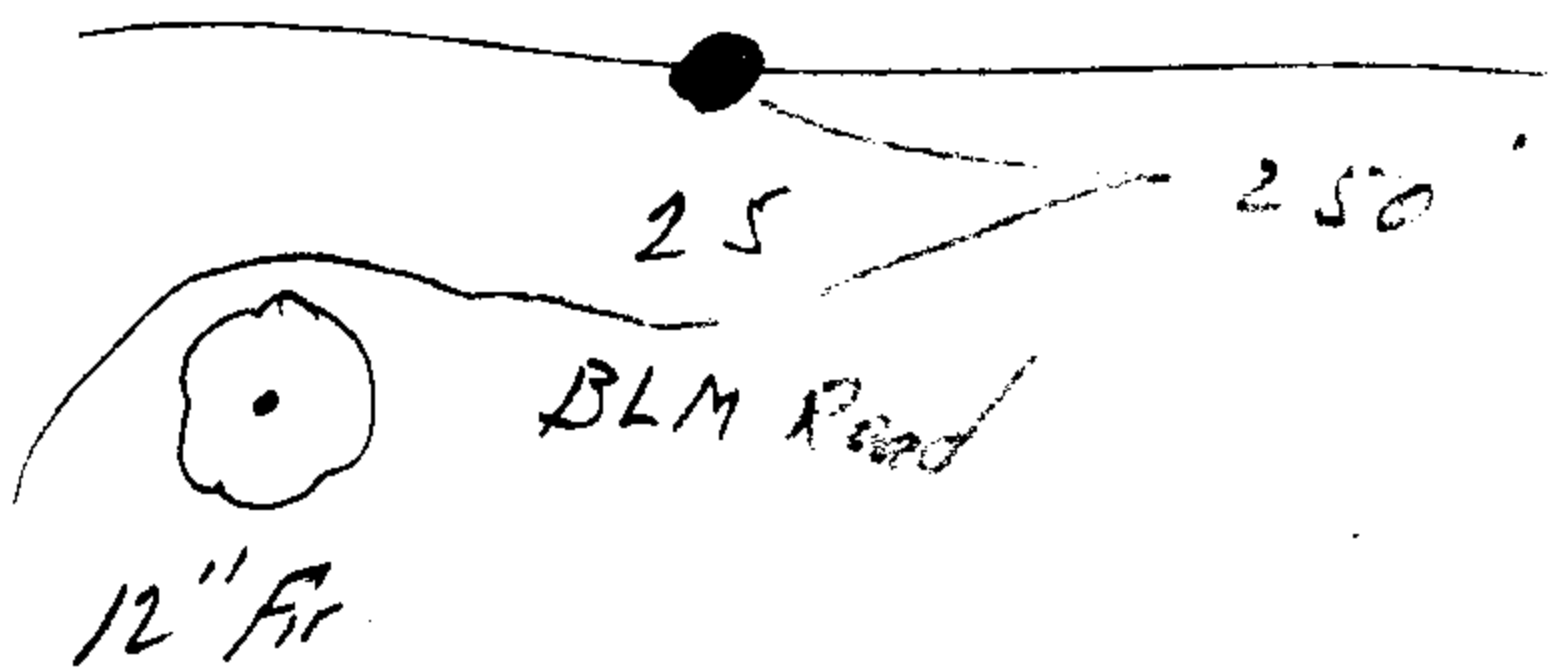

Map No. 49/139