

Renewal

529/528

7285 R6W

Found:

48" Wood Nail 40" N 57 1/2° E 196°

shows eye work

I find this Bearing to be N 65° E

Iron P. Re 3/4" at 7/8 cor


New Bearing Tree:

48" Wood Nail 56 1/2° E 86°

Scribed 1/2 S 28 CS AT

This corner is in corner:

Tied To corners of Barn.

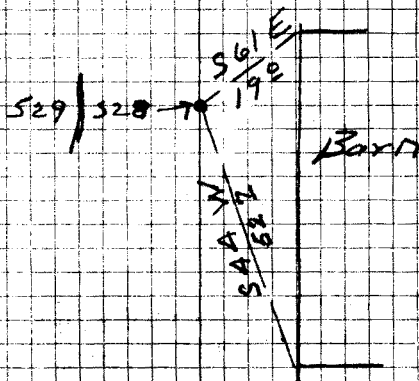

3-30-66

[Handwritten signature]

44

X ✓ O.K. J.B.
#140

C.S. File No. 49/139-114

DIETZGEN NO. 38516