

Renewal

SW cor
DLC #13

T285 R6W

Found:

car stop at DLC cor MKD with
cross (stop broken). Removed
remainder of stop which is 28x21x13
Set Brass cap in its place

11" Bar now 13"
Car is visible

N40 1/2 E T28
SW DLC 13 CS BT
R#429

Renewal

Set Brass cap at DLC cor MKD
County Surveyors office


T285 R6W

SW cor
DLC #13

1968

Bearing Trac at

No other Tracs Available.

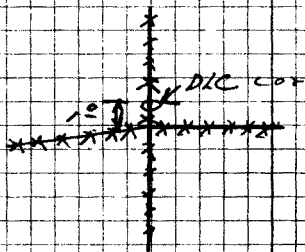

6-27-68

~~Handwritten scribbles~~

D.W. J.W. B

#146

C. S. File No. 49/139-118

DIETZGEN NO. 385-B