

Renewal

COR. NO. ONLY
C 70
C 59

T29S R7W

Found:

2.5" D. Fir New Stump S67E 20^o
Scribe visible W 1/2 CC BT

21" D. Fir NW 3/4 S21W 3/2
shows good scars

Also Brass cap at CC cor M50

General Land Office Survey

C 40

W
5
CC) 59
W
1955

Renewal

New Bearing Tree:

1.5" D. Fir S73E 21^o
Scribed CC 59 CS BT

D.M.
J. W. B.

SEE SKETCH
O.V.P.


10-19-70

[Signature]

#195

G. S. File No. 49/139

DIETZEN NO. 385-6

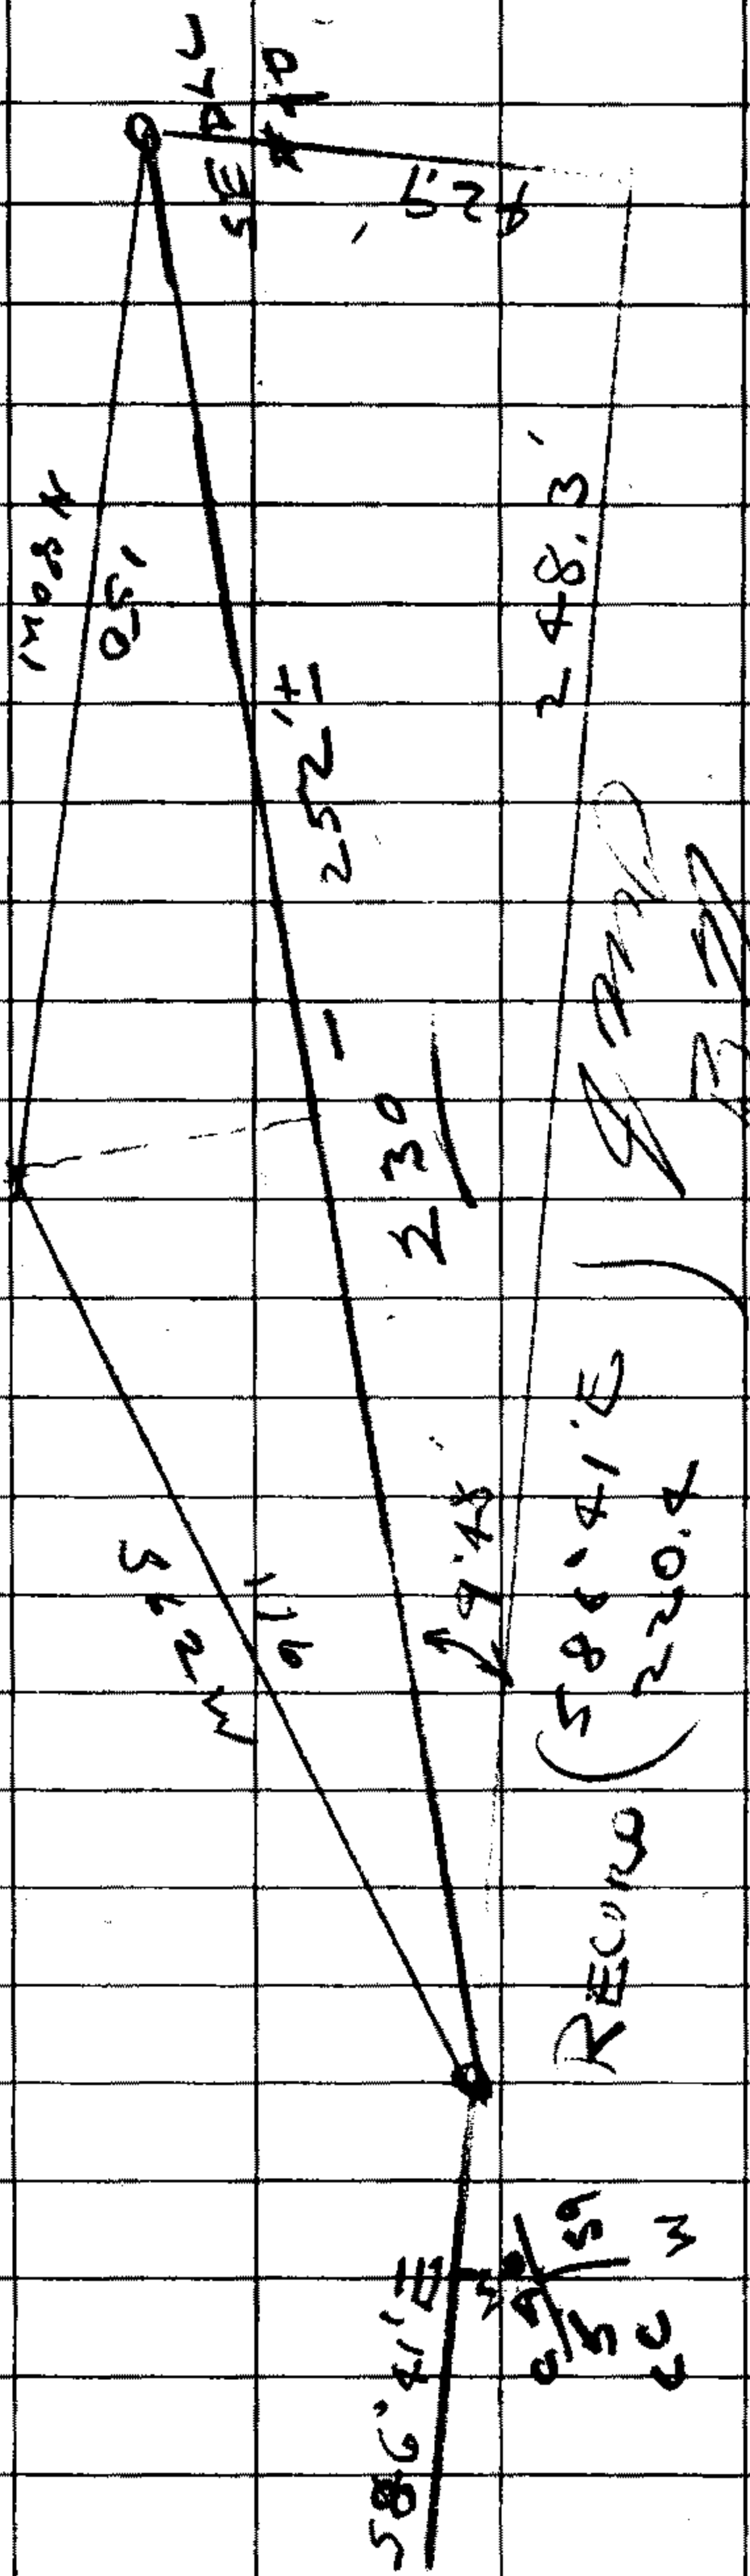

VAR 20°
 (MEASURED WITH SLOTH TAPE
 AND STAFF COMPASS)

COMPUTED