

T 22 S R 6 W W 1/4 S 35

FD. HAINES "T" IRON & CAP

FD 36" CEDAR STUMP N 82° E

38 1/2 FT. SCRIBED "1/4 S 35"

363 B.D."

NO TRACE OF DRIF. B.T.S. FD.


314 1/2 FT. NORTH OF W 1/4 S 35

FD. HAINES "T" IRON & CAP FOR

E. 1/4 SEC. 34.

FD. 14" FIR S 32° W 70 8/10 FT.

SCRIBED "1/4 S 34 BT"

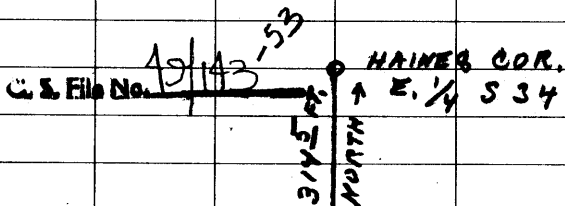

Wils E. Godfrey

AUG. 16, 1961

M. G.
V. T.
C. P.

+