

REN.

T 23 S R 6 W

COR.
SECS.

21

(ON S. LINE T 22 S R 6 W)

AT COR. FD. G. L. O. BRASS CAP,
SET IN 1943.

FD. 48" FIR S 13 1/2° E (NOT S 26 1/2° E)
71 1/2 FT. - VERY PLAIN AXE SCAR.

FD. 54" FIR S 67° W 134 1/2 FT.
UPROOTED & DOWN.

BLAZE & SCRIBE NEW TREES:

12" WHITE FIR S 62° W 27 1/2 FT.
MKD. "T 23 S R 6 W S 2 C S BT"

8" WHITE FIR S 66° E 14 1/2 FT.
MKD. "T 23 S R 6 W S 1 C S BT"

FEB. 26, 1964


Hubert E. Godfrey

M.G.
W.S.
M.S.

~~XXXX~~

C. S. File No. 49/143-97

Section 1 Twp 23 Rge 6 N Date: 2-7-64

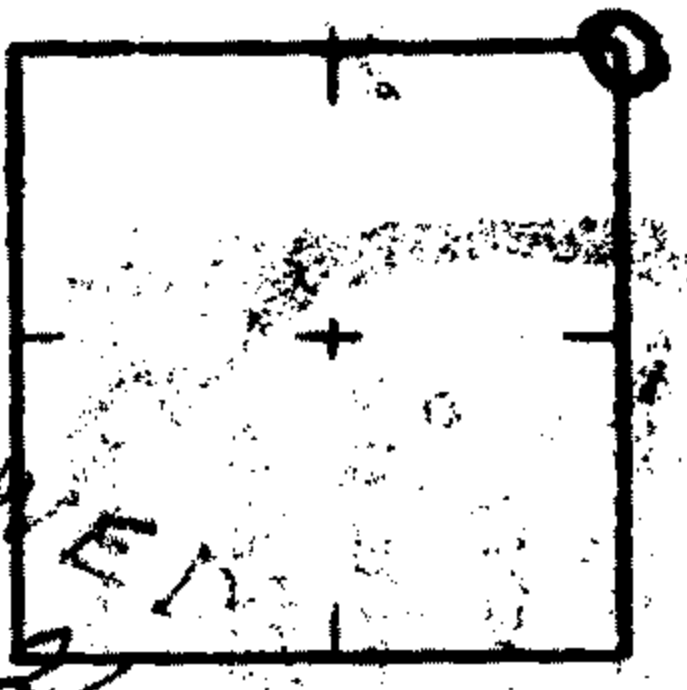

SEARCHED
INDEXED
SERIALIZED
FEB 12 1964

How was corner identified? BRASS CAP - U.S. LAND SURVEY 1843

Condition of corner: Needs Additional B.T.S.

Best route to reach corner: By - YONCALLA, west from YONCALLA ON THE

HAYHURST Rd. TO JUNCTION OF SKELLY Rd. - SOUTH ON SKELLY

Quadrant	NE	NW	SE	SW
Species & Size		46" D.F.		
Dist. & Bearing		60 FT S 10° E		
Condition of Scribe		INDICATION		
Original or Resurvey		LOOKS LIKE AN ORIGINAL		
Appearance of B.T.		GOOD		
Tags, Markings, etc.		NRS LOCATION TAG		

Other Remarks:

AD. TURN RIGHT AT JUNCTION

ENTER RT. THE MYRES HOUSE,

USING THERE AD. SEC 1

LAYS 1/4 MI ABOVE.

ED WARE BLM.

Blended