

Wilford N. Haines
 Drain, Oregon 97435
 Dec 1967

North ↑

① 5/8 steel Rod

N 32° 30' W
 122.94


REGISTERED
 OREGON
 LAND SURVEYOR

Wilford N. Haines

MAY 7, 1948
 WILFORD N. HAINES
 239

At the corner common to
 sects. 23, 24, 25 & 26 T. 21 S., R. 6 W.,
 The corner is likely to be destroyed
 by logging operations

so I put in the rebo pts.
 shown

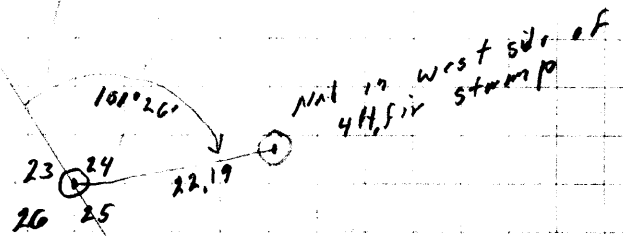

23 24
 26 25

N 32° 30' W
 67.32

Nail in top of →
 4th fir stump