


RENEW NW COR D/LC 63 T 275 R 6 W

FOUND - BRASS CAP SET BY EVANS. NOW
2" UNDER SURFACE. I SET BRASS CAP
OVER EVANS BRASS CAP AND MARK
NW COR D/LC 63 T 275 R 6 W COUNTY
SURVEYORS OFFICE 1959.

NOTE - I PLACE CONC COLUMN AROUND
NEW BRASS CAP.

NEW TIES TO BEARING OBJECTIVES.

DIETZGEN NO. 388-6

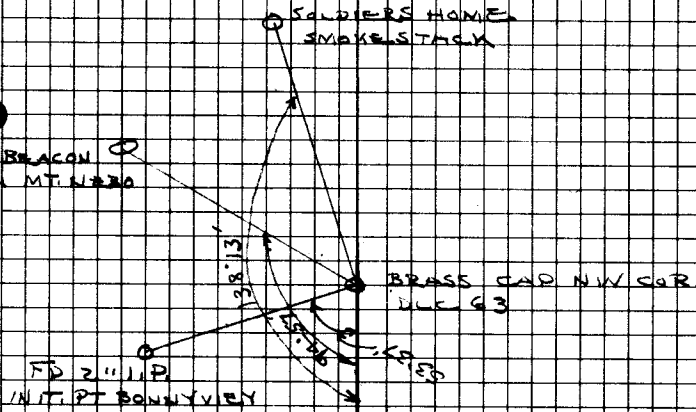

APRIL 13-59
J. BYRON
W. GORRELY
S. BILLOWI