


FILED
RECEIVED

AUG 26 1959

COUNTY SURVEYOR
DOUGLAS COUNTY, ORE.

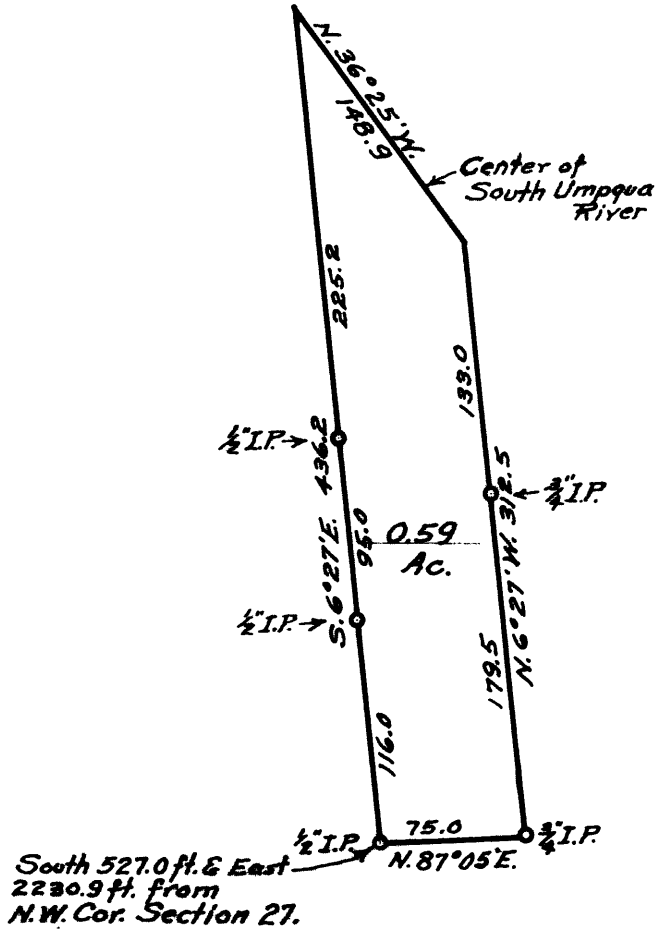

COUNTY SURVEYOR'S OFFICE
DOUGLAS COUNTY, OREGON.
SURVEY FOR
DON BLOSS. SEC. 27, T.30S., R.5W.
Geo. J. Wenderoth, Deputy, Aug. 1959
SCALE 1"=100'

REGISTERED
OREGON
LAND SURVEYOR

Geo. J. Wenderoth

MARCH 10, 1944
George J. Wenderoth
5

COUNTY SURVEYORS FILE DATA
DO NOT REMOVE FROM OFFICE