


COUNTY SURVEYORS FILE DATA  
DO NOT REMOVE FROM OFFICE

185  
210  
215

1072  
1180  
1242

31 32  
T.24S.R.3W.

A. V. ABEENE  
SEC. 31, T. 24 S. R. 3 W.  
JUNE 1951. 1" = 50'  
FRED L. DOW  
REG. ENG.

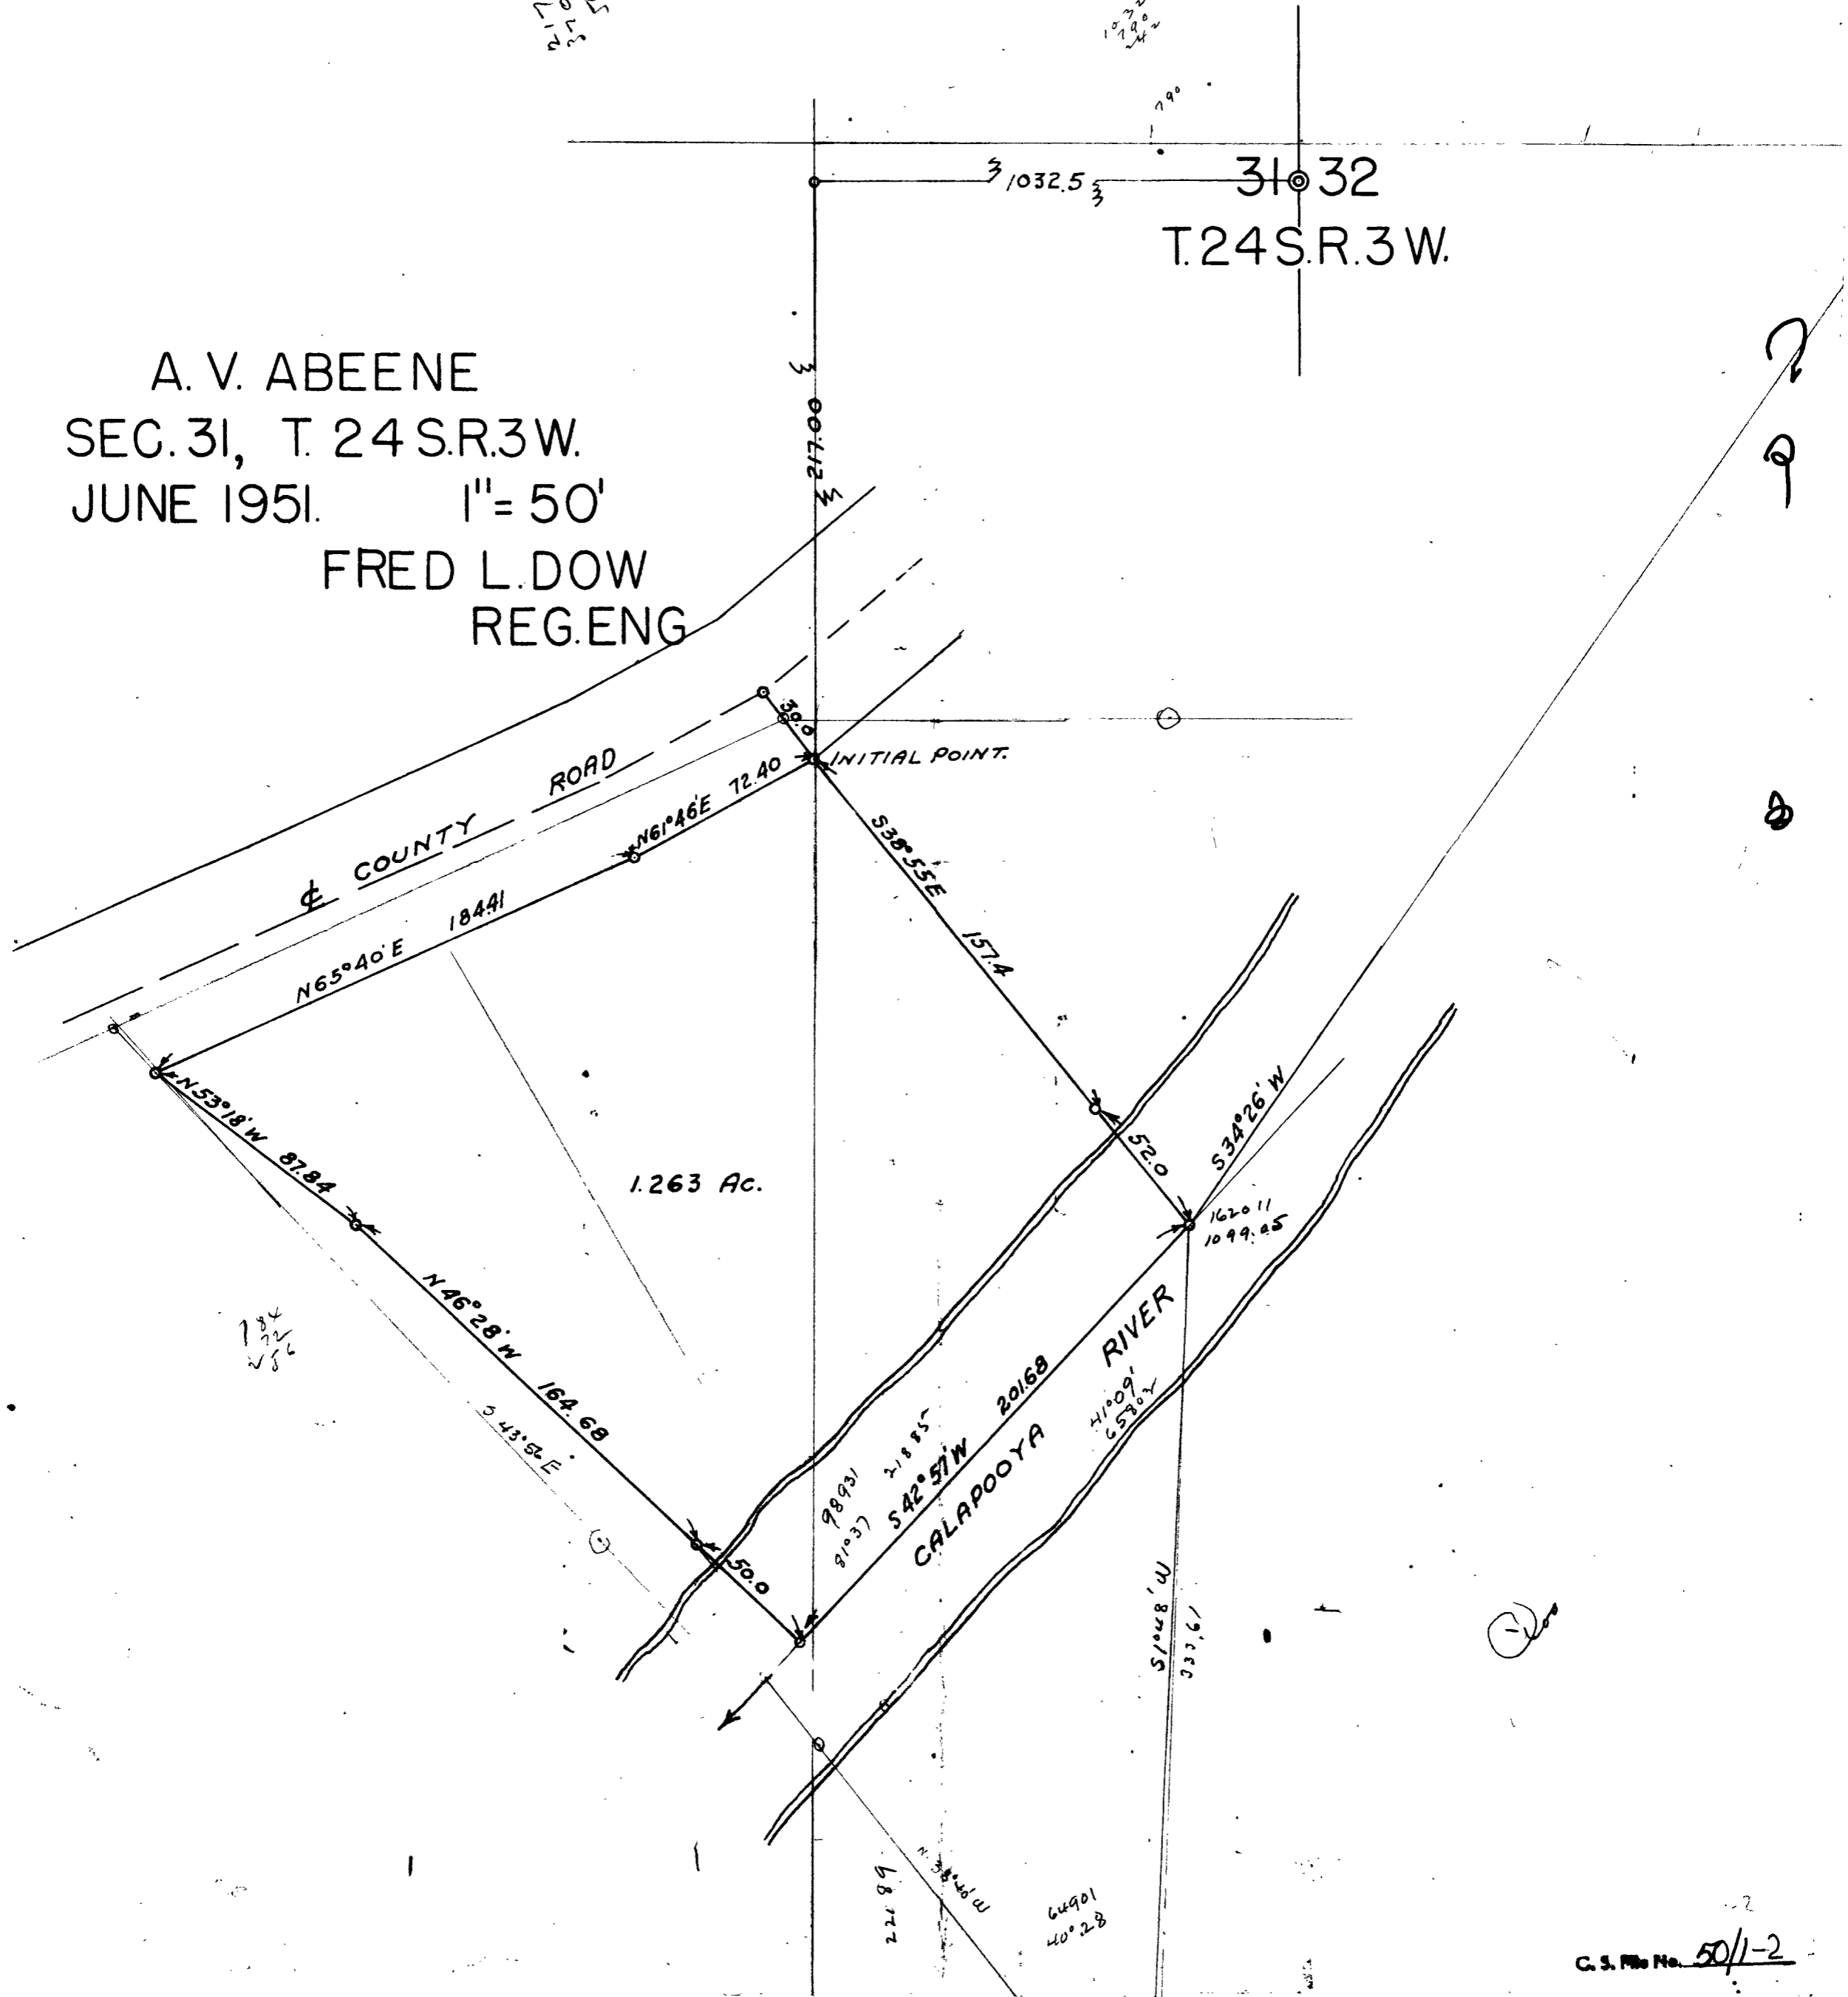

184  
172  
156

INITIAL POINT.

1.263 Ac.

98931  
91°37'

218.85'

S42°57'W

2016.8

11009'

6530.4

1620.11  
1099.25

S10°48'W  
1915.5

221.89

109°36'N

64901  
40°28'