


T. 29 S. R. 4 W.

19 20
30 29

MRS. ALTAVERNE CROY
MYRTLE CREEK
OCTOBER 1953 FRED. L. DOW

1" = 100'

REG. ENG.

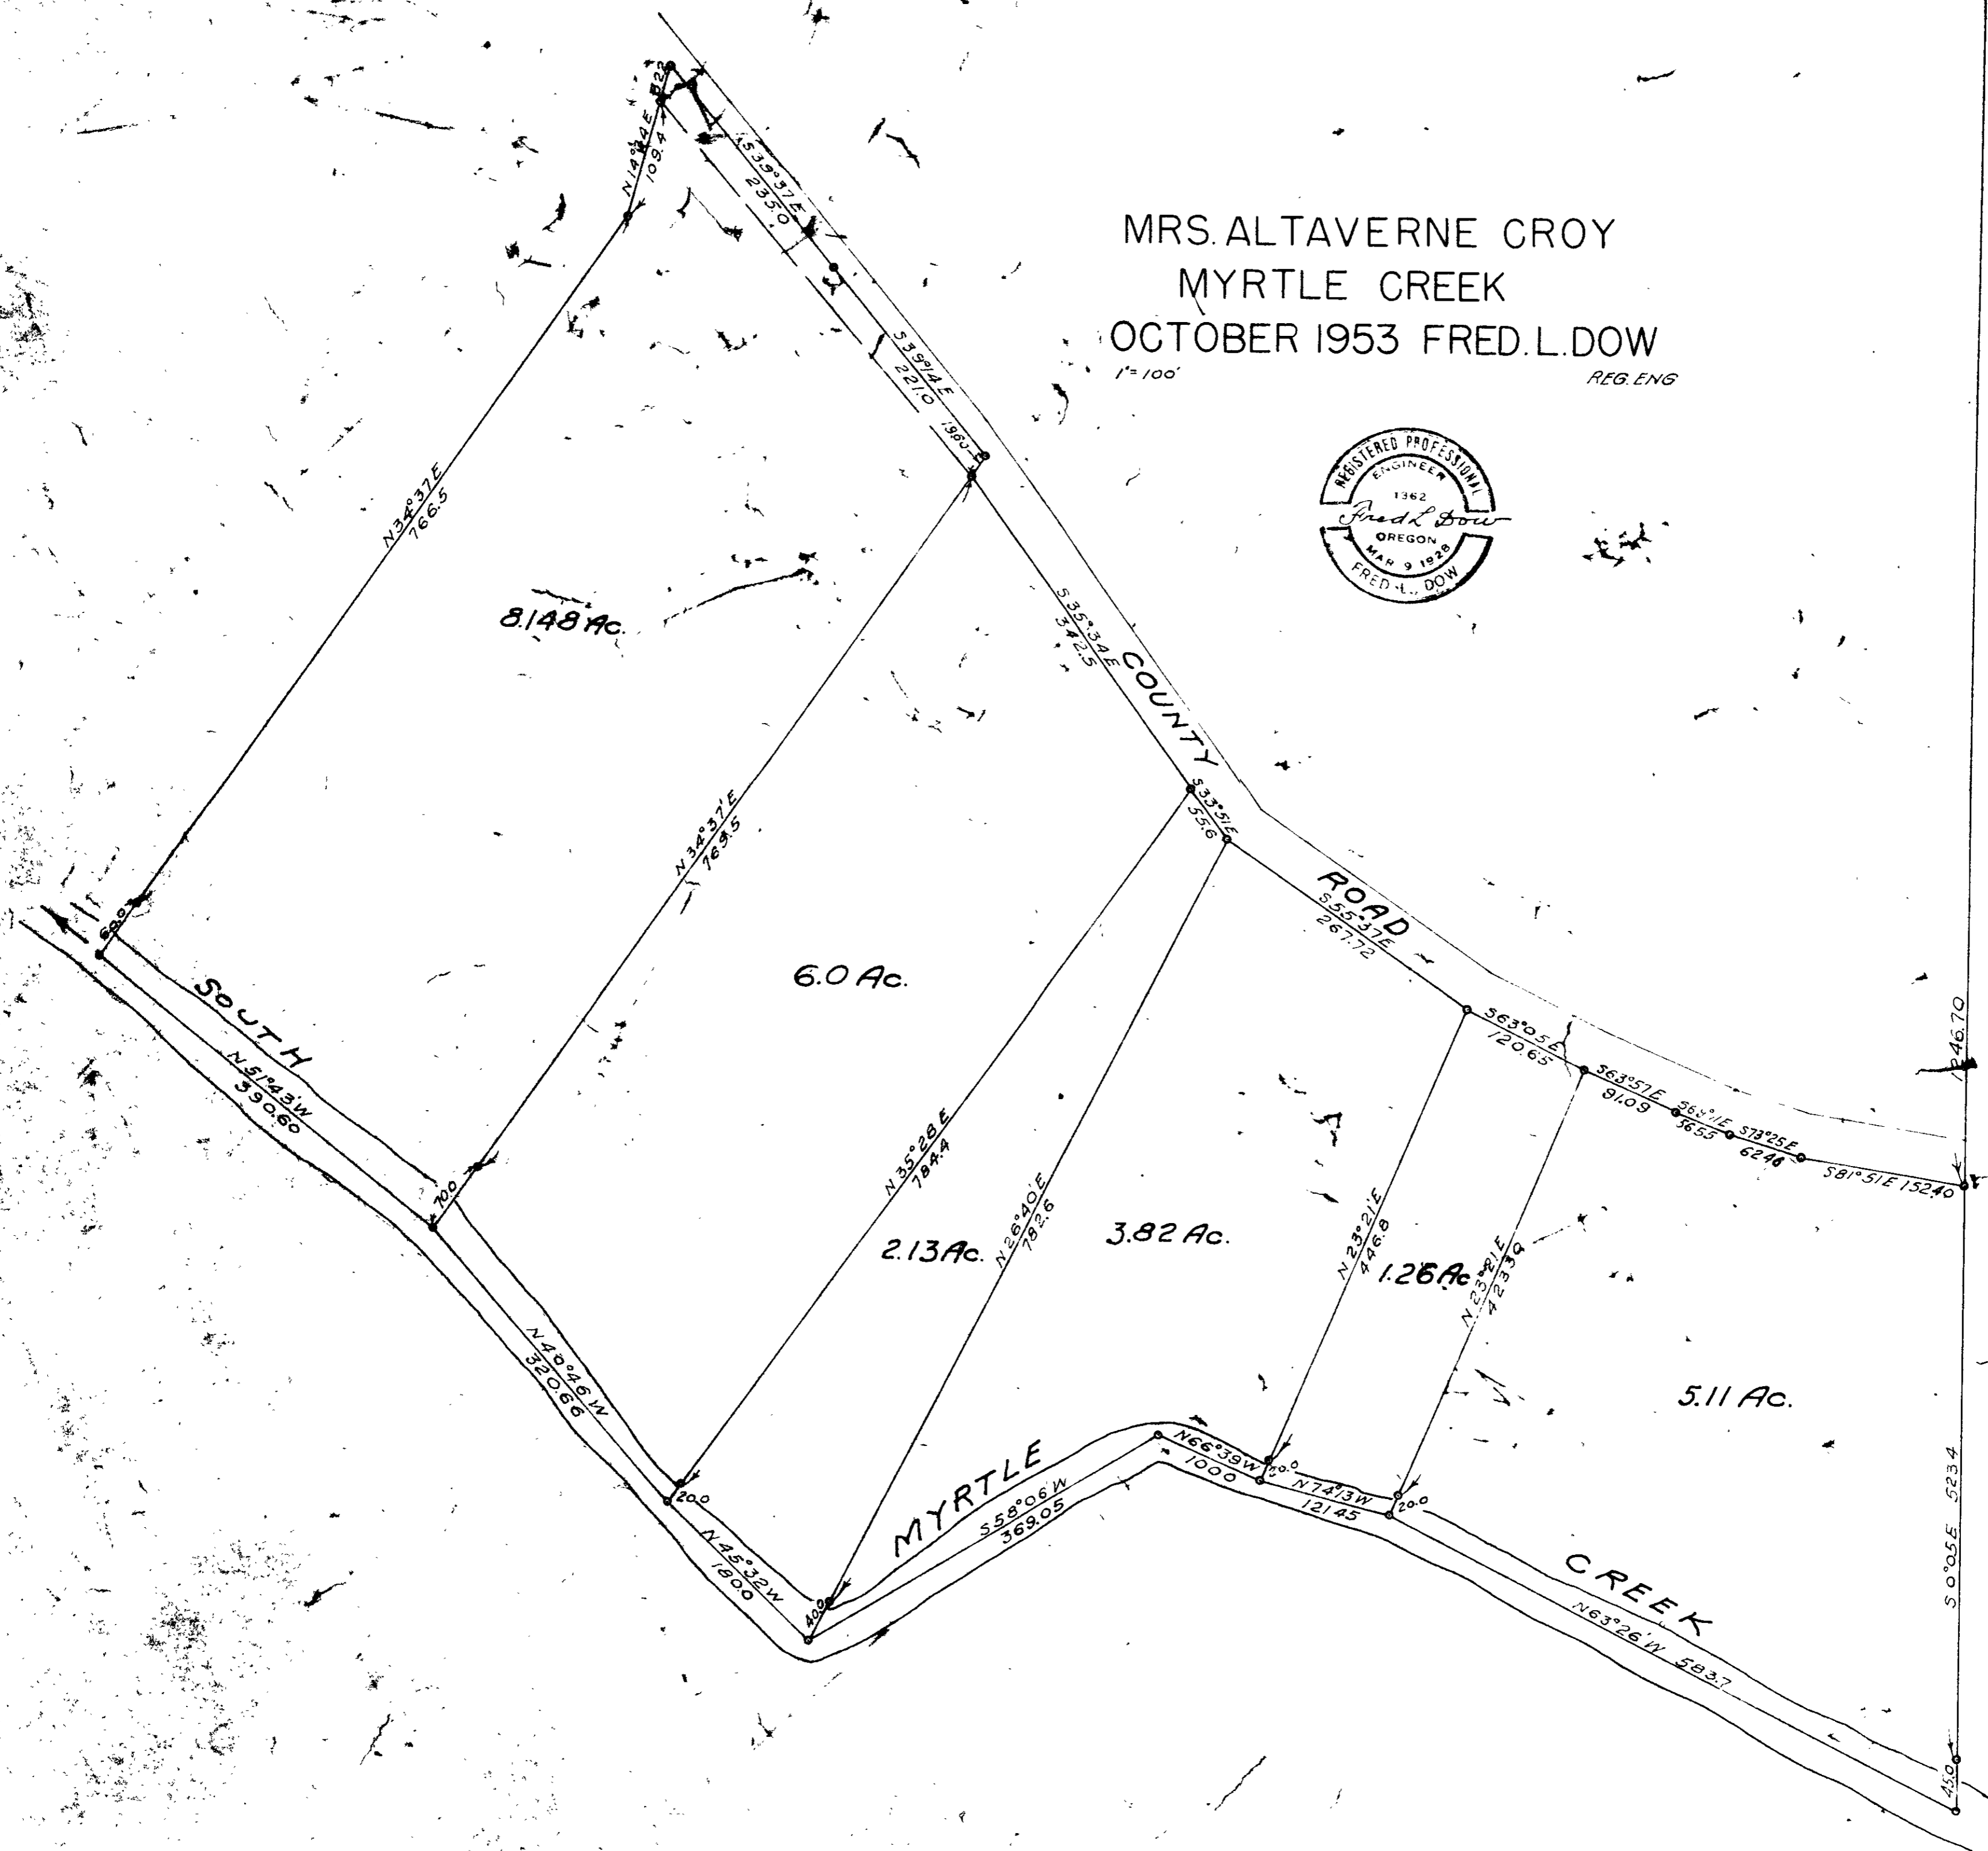

2