


1320
814.3
814.3

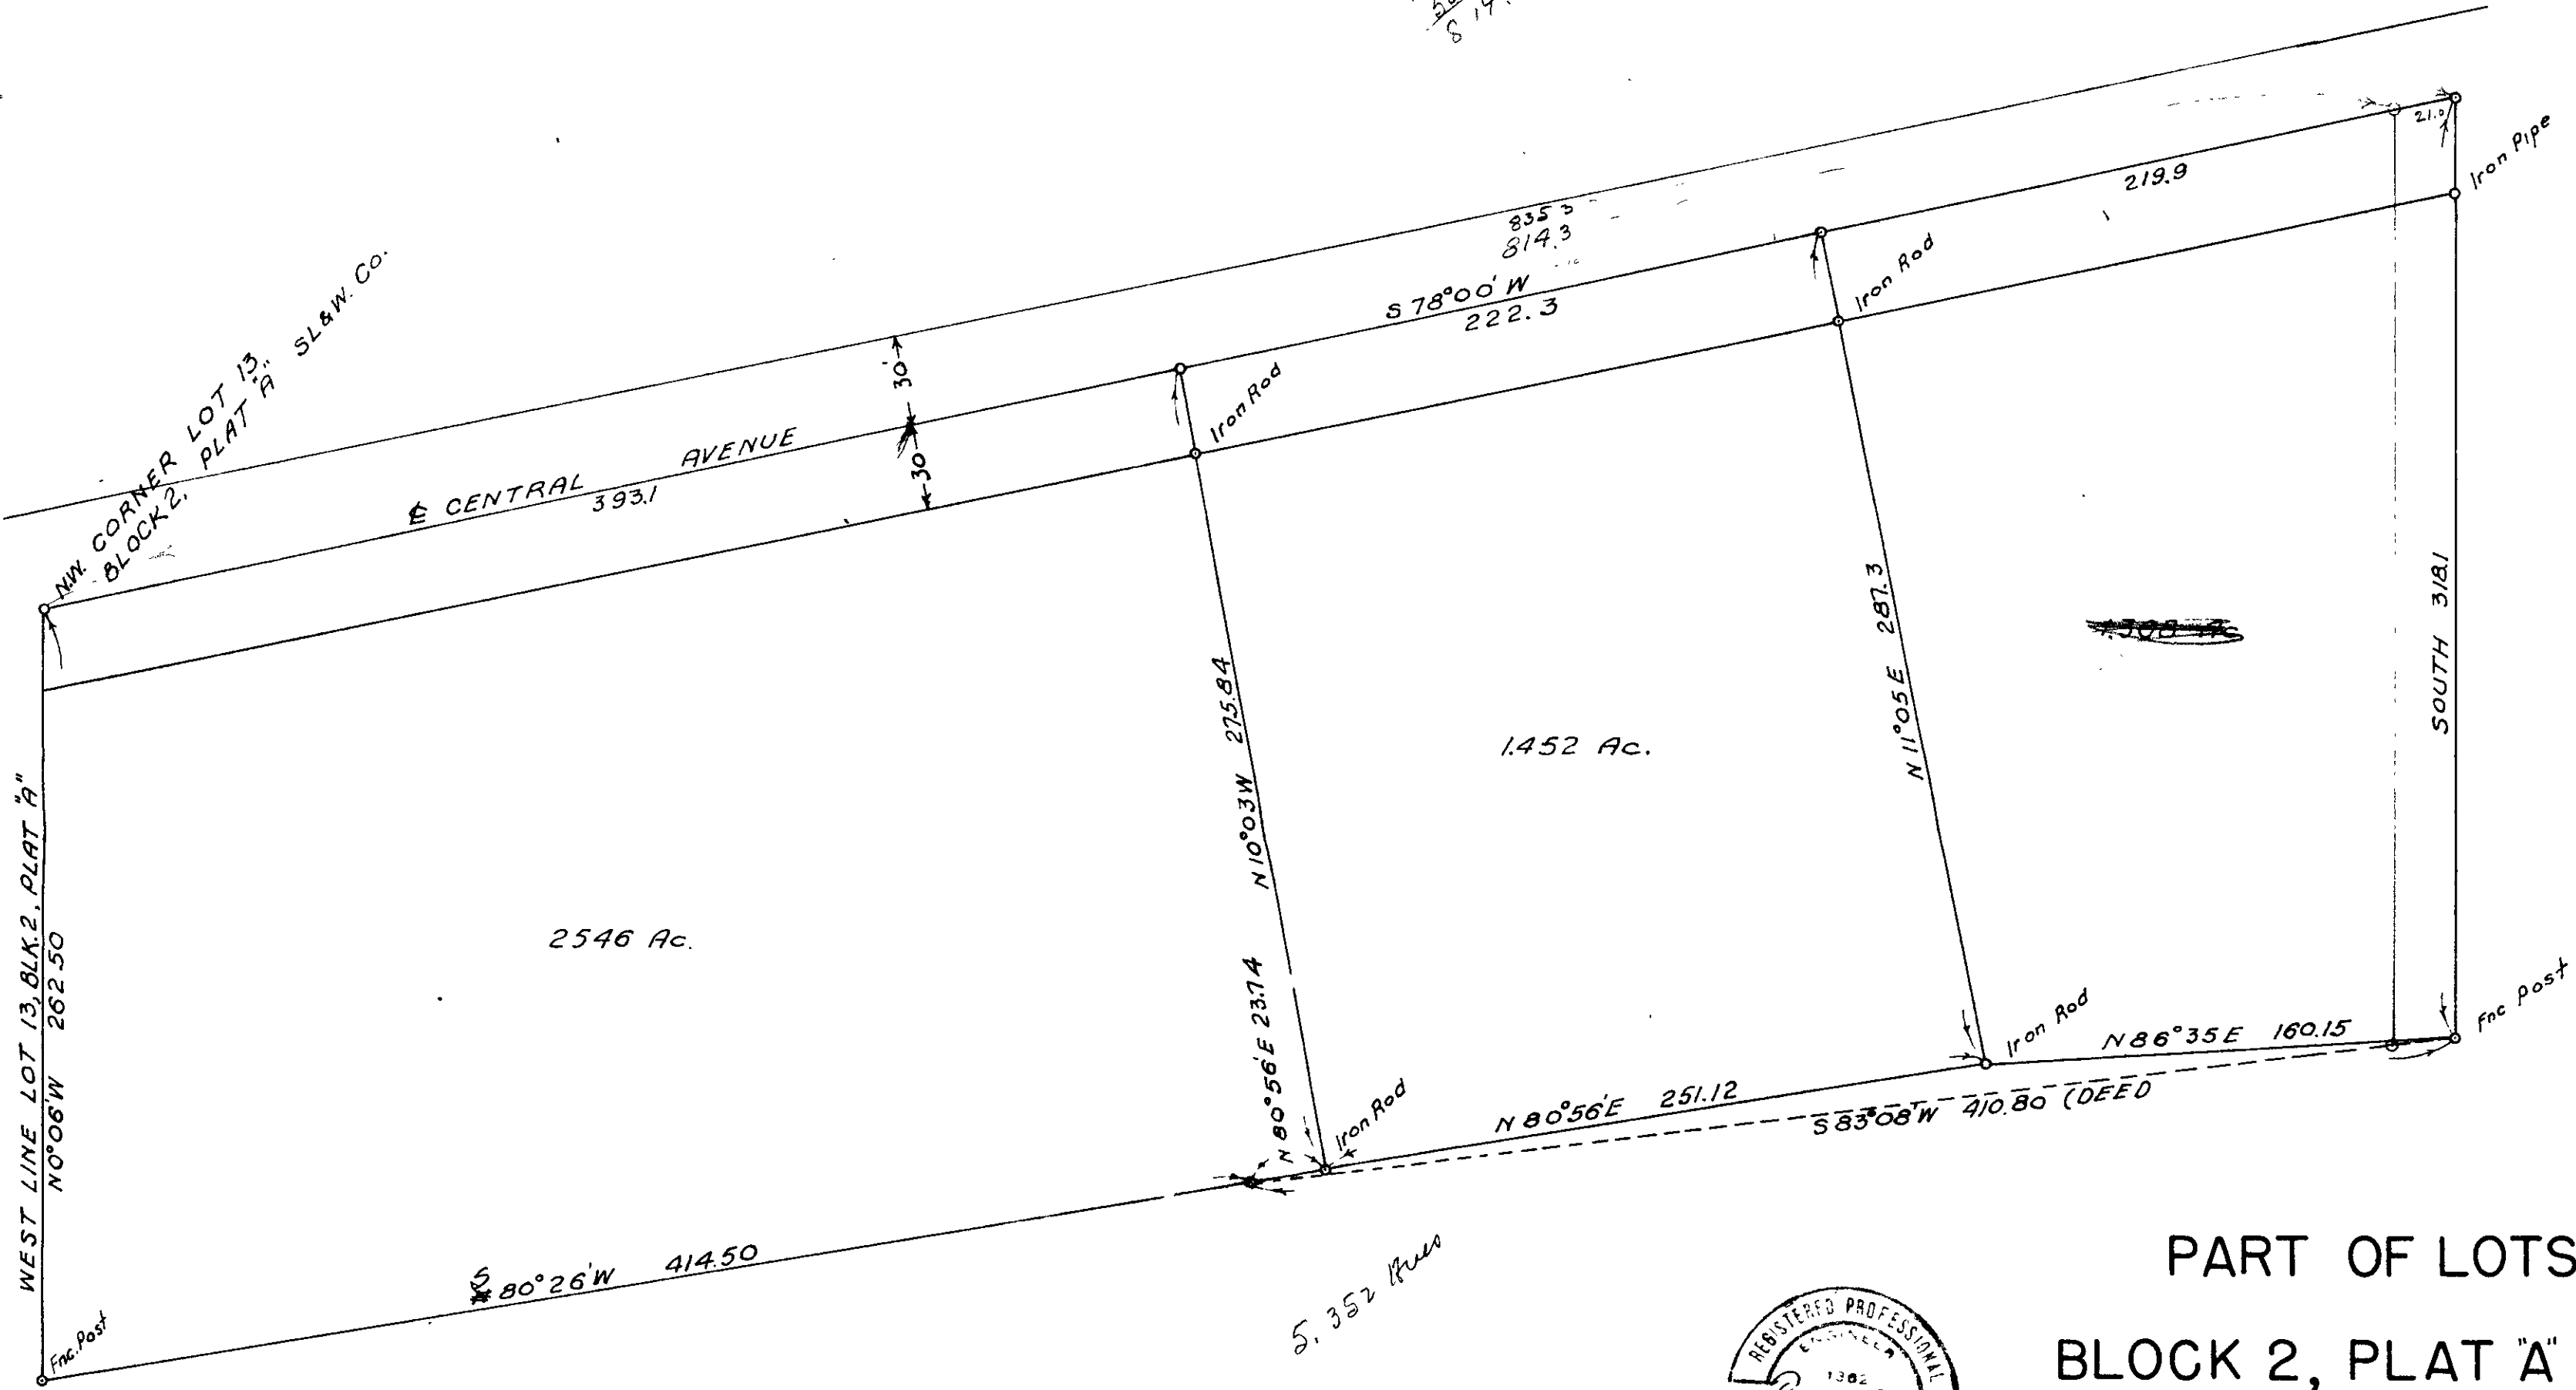

PART OF LOTS 13 & 14
 BLOCK 2, PLAT "A" S.L. & W. Co.
 SUTHERLIN
 FEBRUARY 1955 1" = 50'

FOR OFFICIAL RECORD
 FILED