


NOTE -
 Bearings shown are based on the bearing
 of N 29°00' E for E. of Sou Pacific R.R. tracks.
 None of the original points on Krewson's
 Addition to Drain could be identified on the
 ground. Fence lines were checked, and the fence
 line along the South boundary of Lots 3, 4, Block
 6 check nearest to the bearings and distances given
 on the filed plot of Krewson's Addition to Drain, and
 was used as the base for this survey.

COUNTY SURVEYOR'S OFFICE
 DOUGLAS COUNTY, OREGON
 SURVEY FOR DEED DESCRIPTION,
 IN CITY OF DRAIN, ORE.

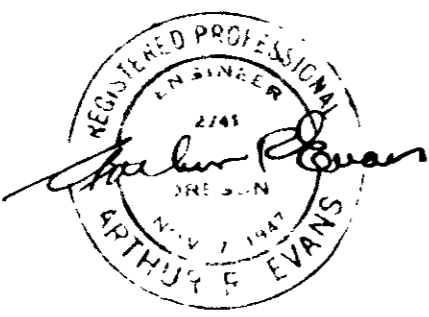

BEN B. IRVING
 SURVEYED AUG. 18, 1949.
 A. R. EVANS

COUNTY SURVEYOR
 BY
 DEPUTY

SCALE 1" = 40'

FOR ORIGINAL
 TRACING SEE
 M 14-54