


BLOCK ONE - PLAT 'A'

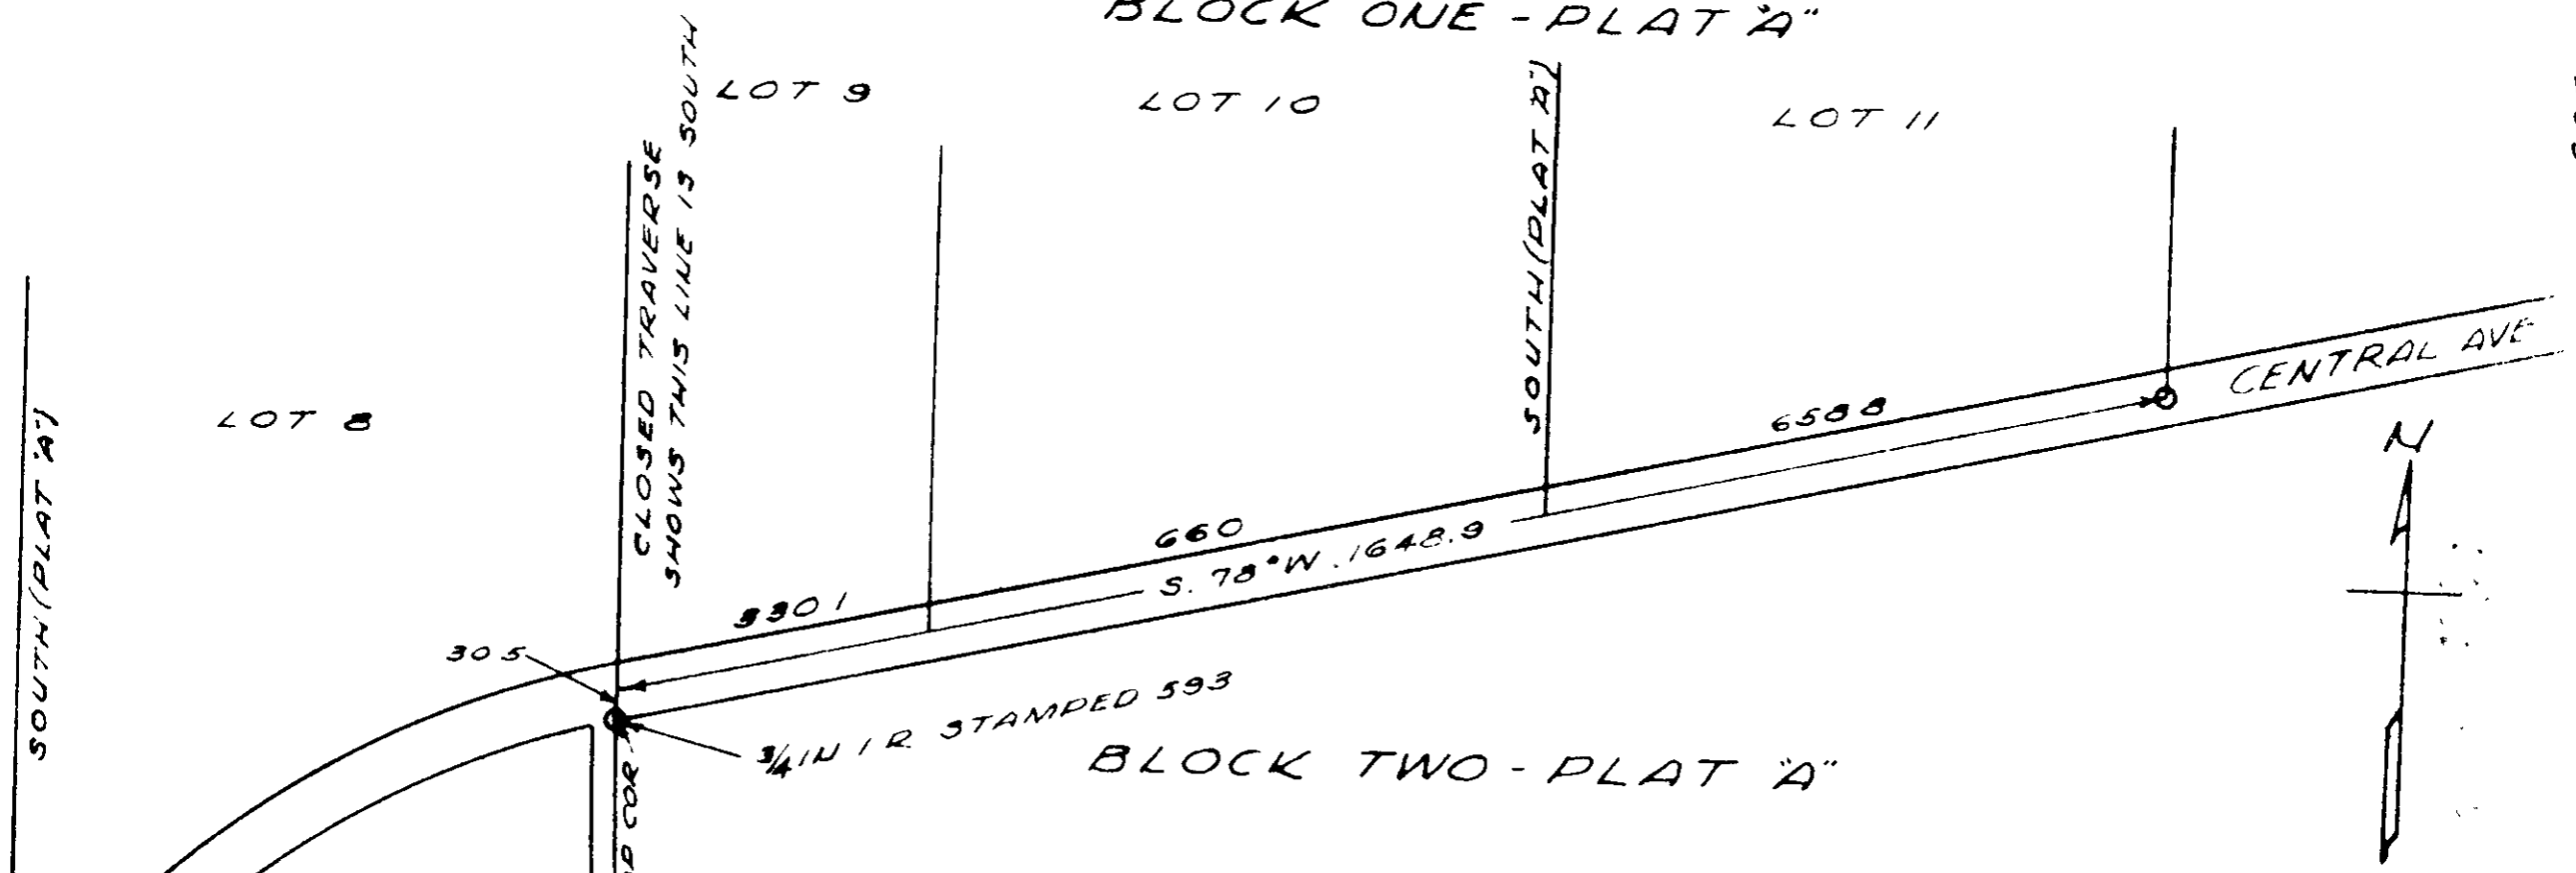

CLOSED TRAVERSE SHOWS THIS LINE IS SOUTH

SOUTH (PLAT 'A')

SOUTH (PLAT 'A')

CENTRAL AVE



BLOCK TWO - PLAT 'A'

ESTABLISHING NE PROPERTY CORNER OF LOT 7, BLOCK 2 PLAT 'A' SUTHERLIN LAND & WATER CO FOR DAVID SCOTT SUTHERLIN OREGON.

SURVEYED FEB 10-11 & APRIL 19, 1940  
SCALE 1" = 200 FT

*Handwritten signature*

COUNTY SURVEYORS FILE DATA  
DO NOT REMOVE FROM OFFICE

N 68° 24' E	217.8
ROBINSON	
SPRACHER	
217.8	
S 68° 24' W	

3871 ALLE  
100' 100'  
31.95' E  
500.51 TO PROB COR

305

9301

660

S. 78° W. 1648.9

6588

3/4 IN I.R. STAMPED 593

LOT 8

LOT 10

LOT 11

LOT 9

LOT 7 BLK 2