


Wm. E. McDANIEL  
YONCALLA  
LOTS 8,9,10,11,12 & 13  
PLAT "B"

YONCALLA ORCHARD TRACTS  
T. 23 S. R. 5 W.

SEC 4, SESW 2.5 Ac.

SEC 4, SWSE 1.5 Ac

1/4 COR. NORTH LINE W.  
SEC 9, T. 23 S. R. 5 W.

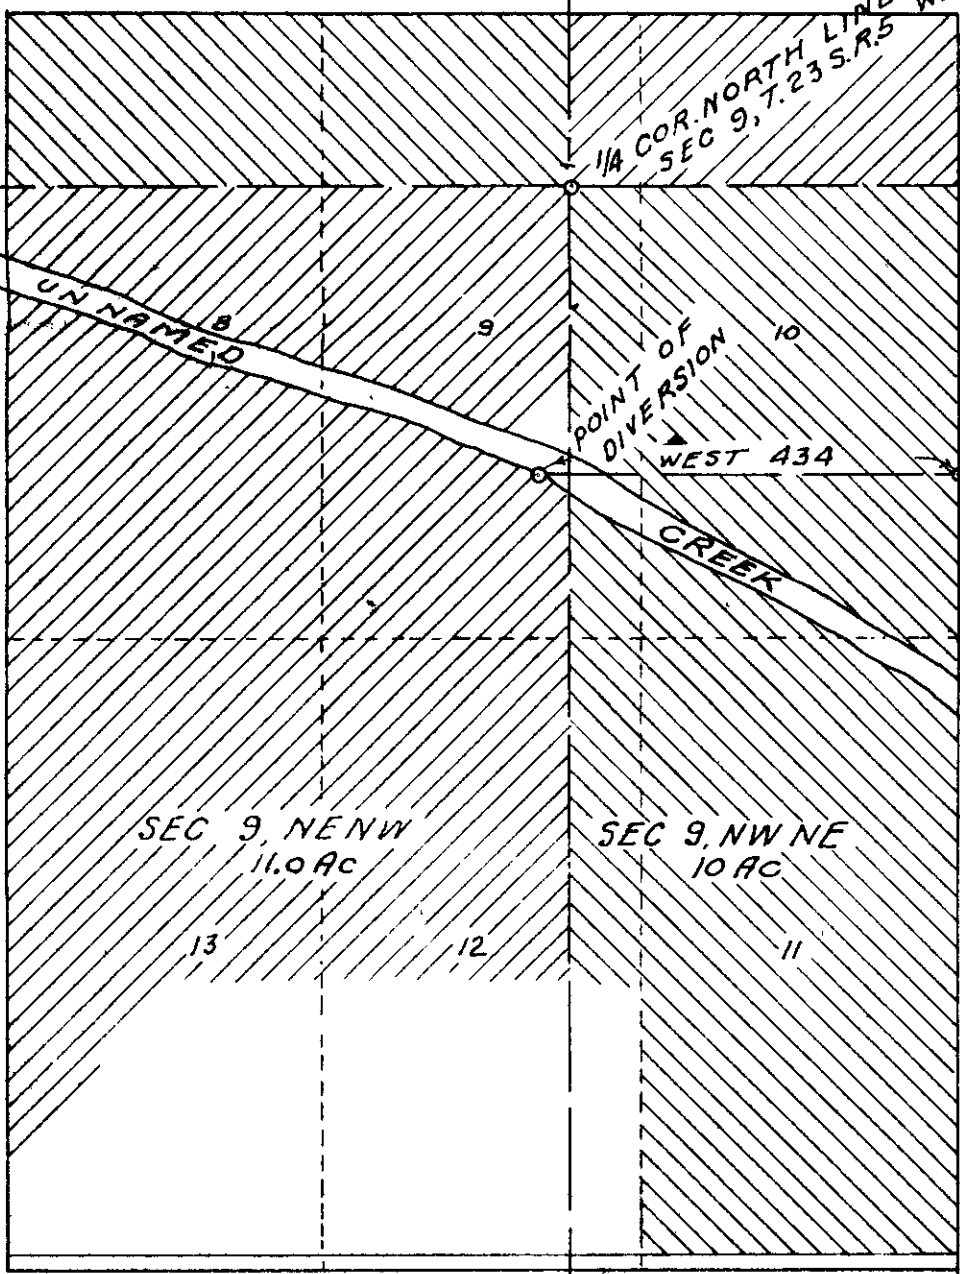

SE. COR. DLC No 37  
SEC 9, T. 23 S. R. 5 W.