


# ALLAN McDONALD DRAIN SECTION 17, T. 22 S. R. 5 W.

SCALE 1" = 50'

APRIL 1954

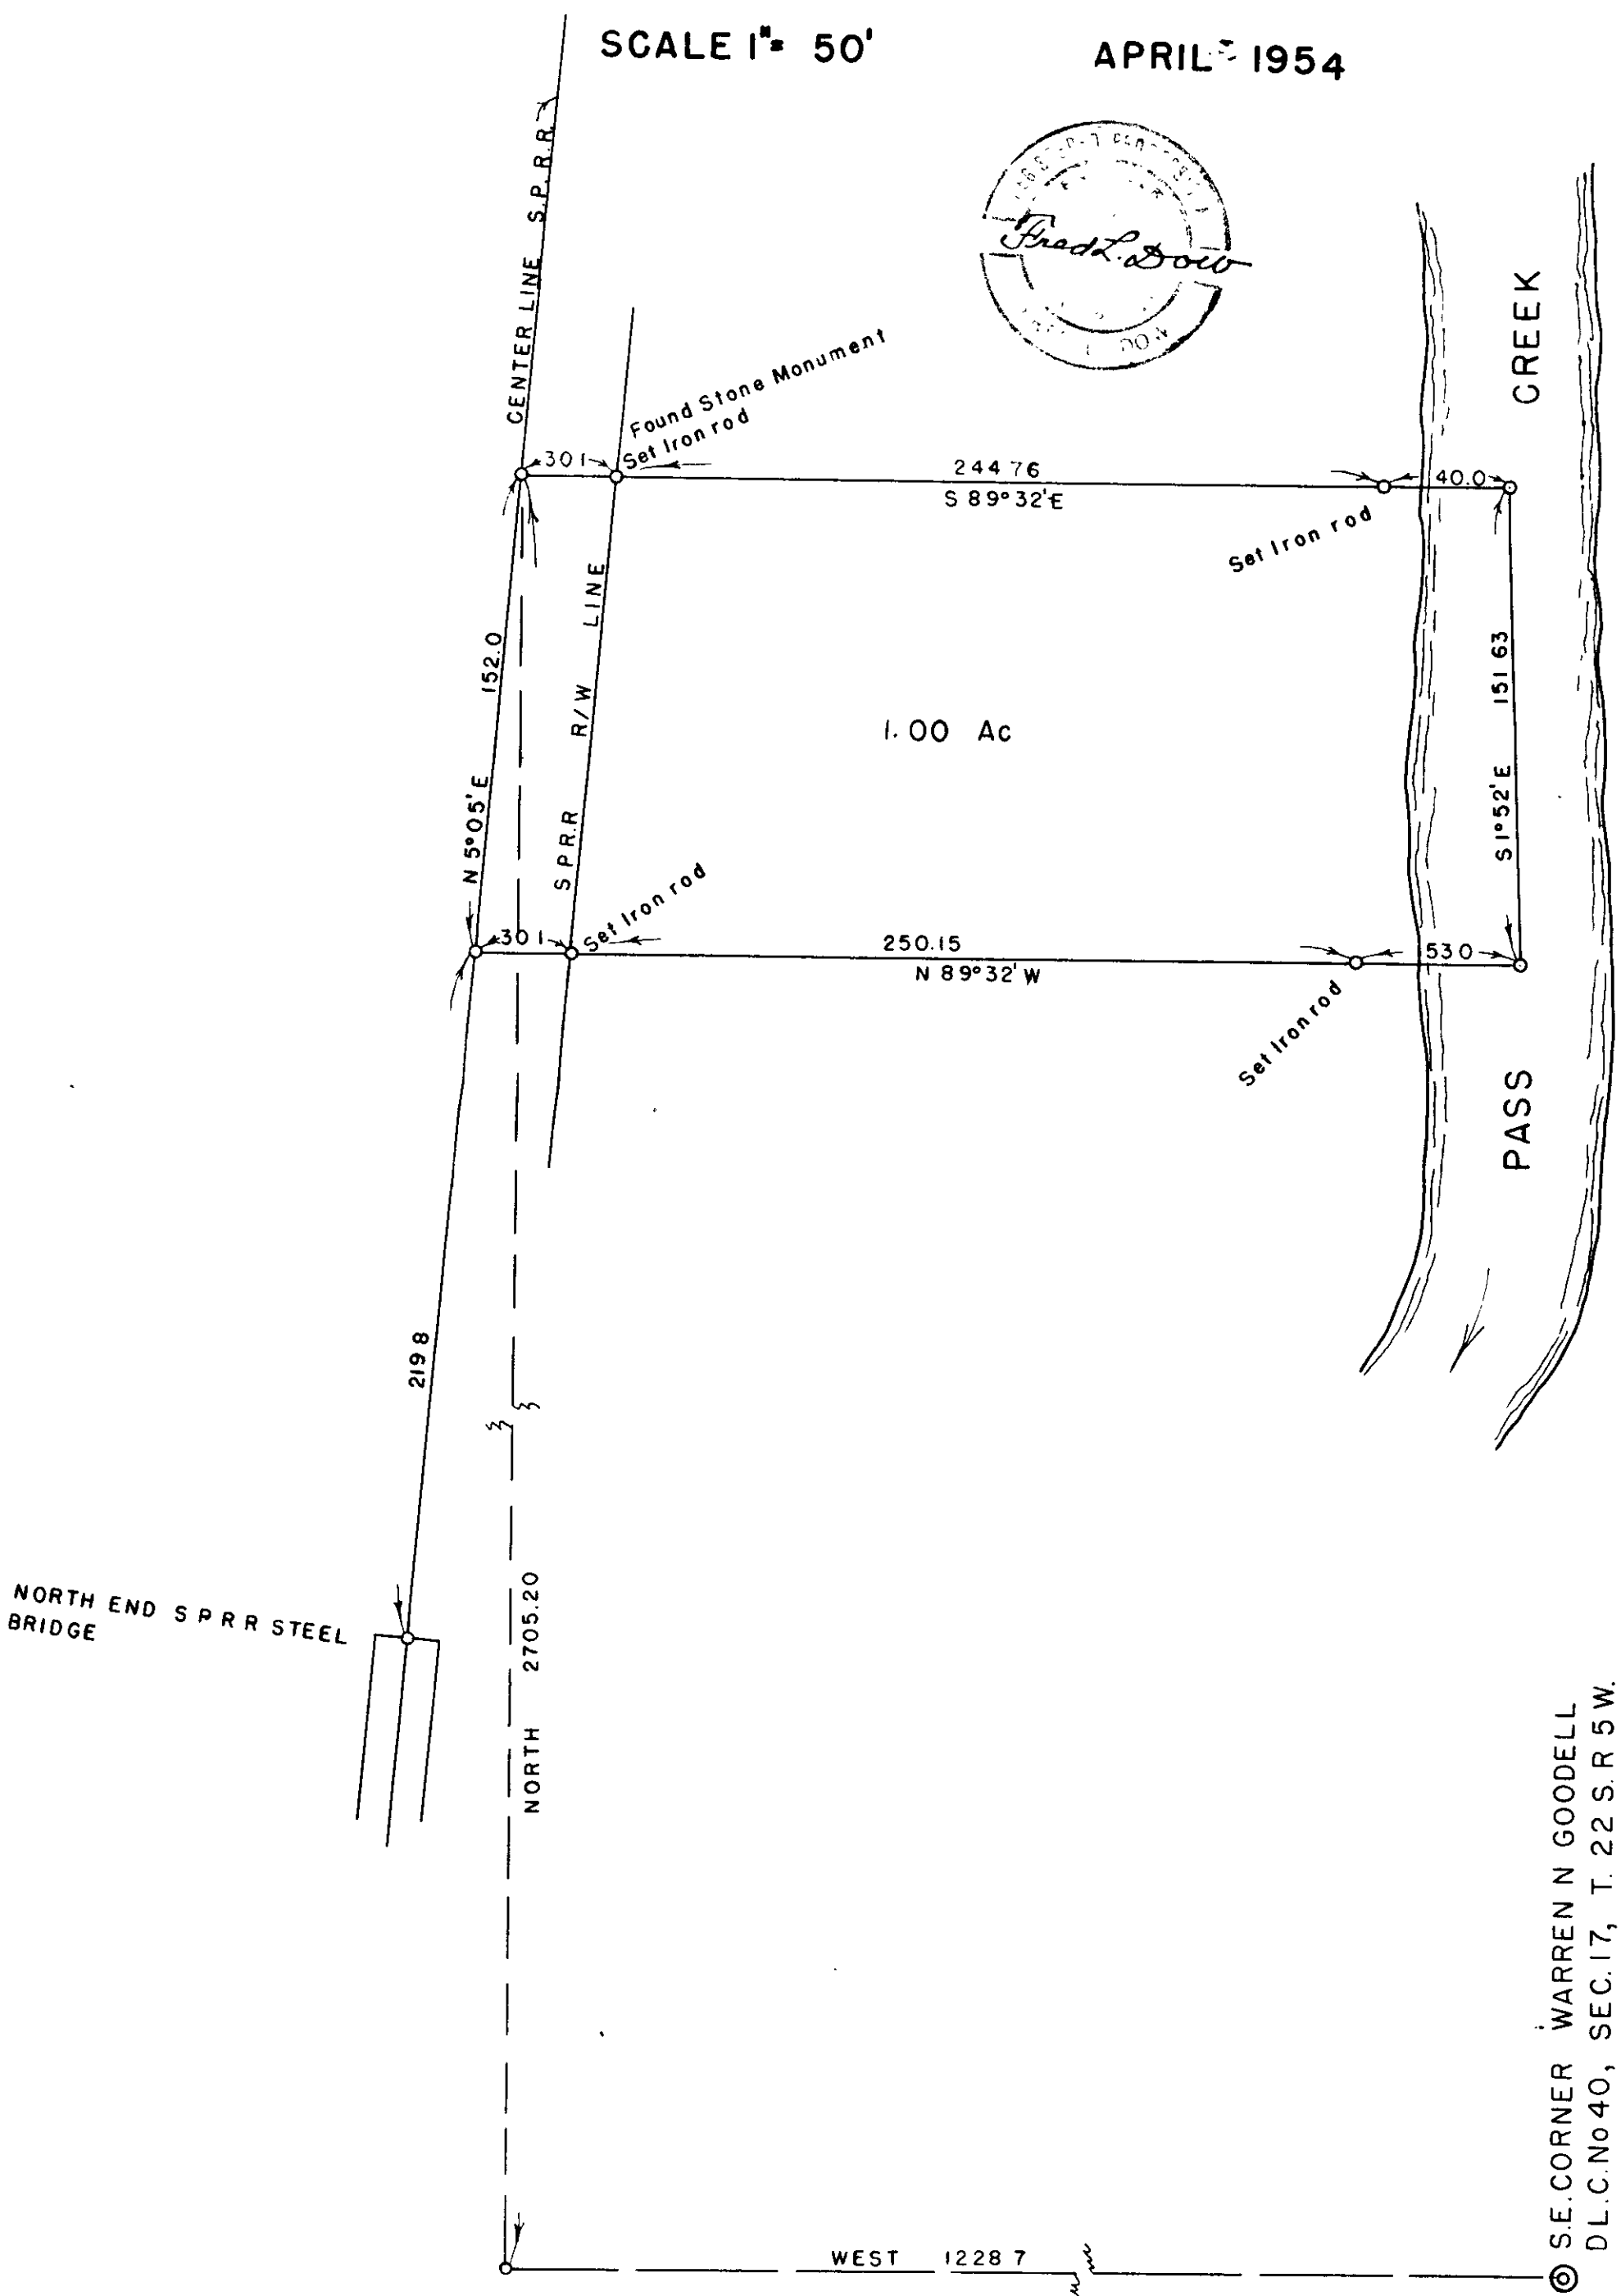

© S.E. CORNER WARREN N GOODELL  
D.L.C. No 40, SEC. 17, T. 22 S. R. 5 W.