


PLAT "L"

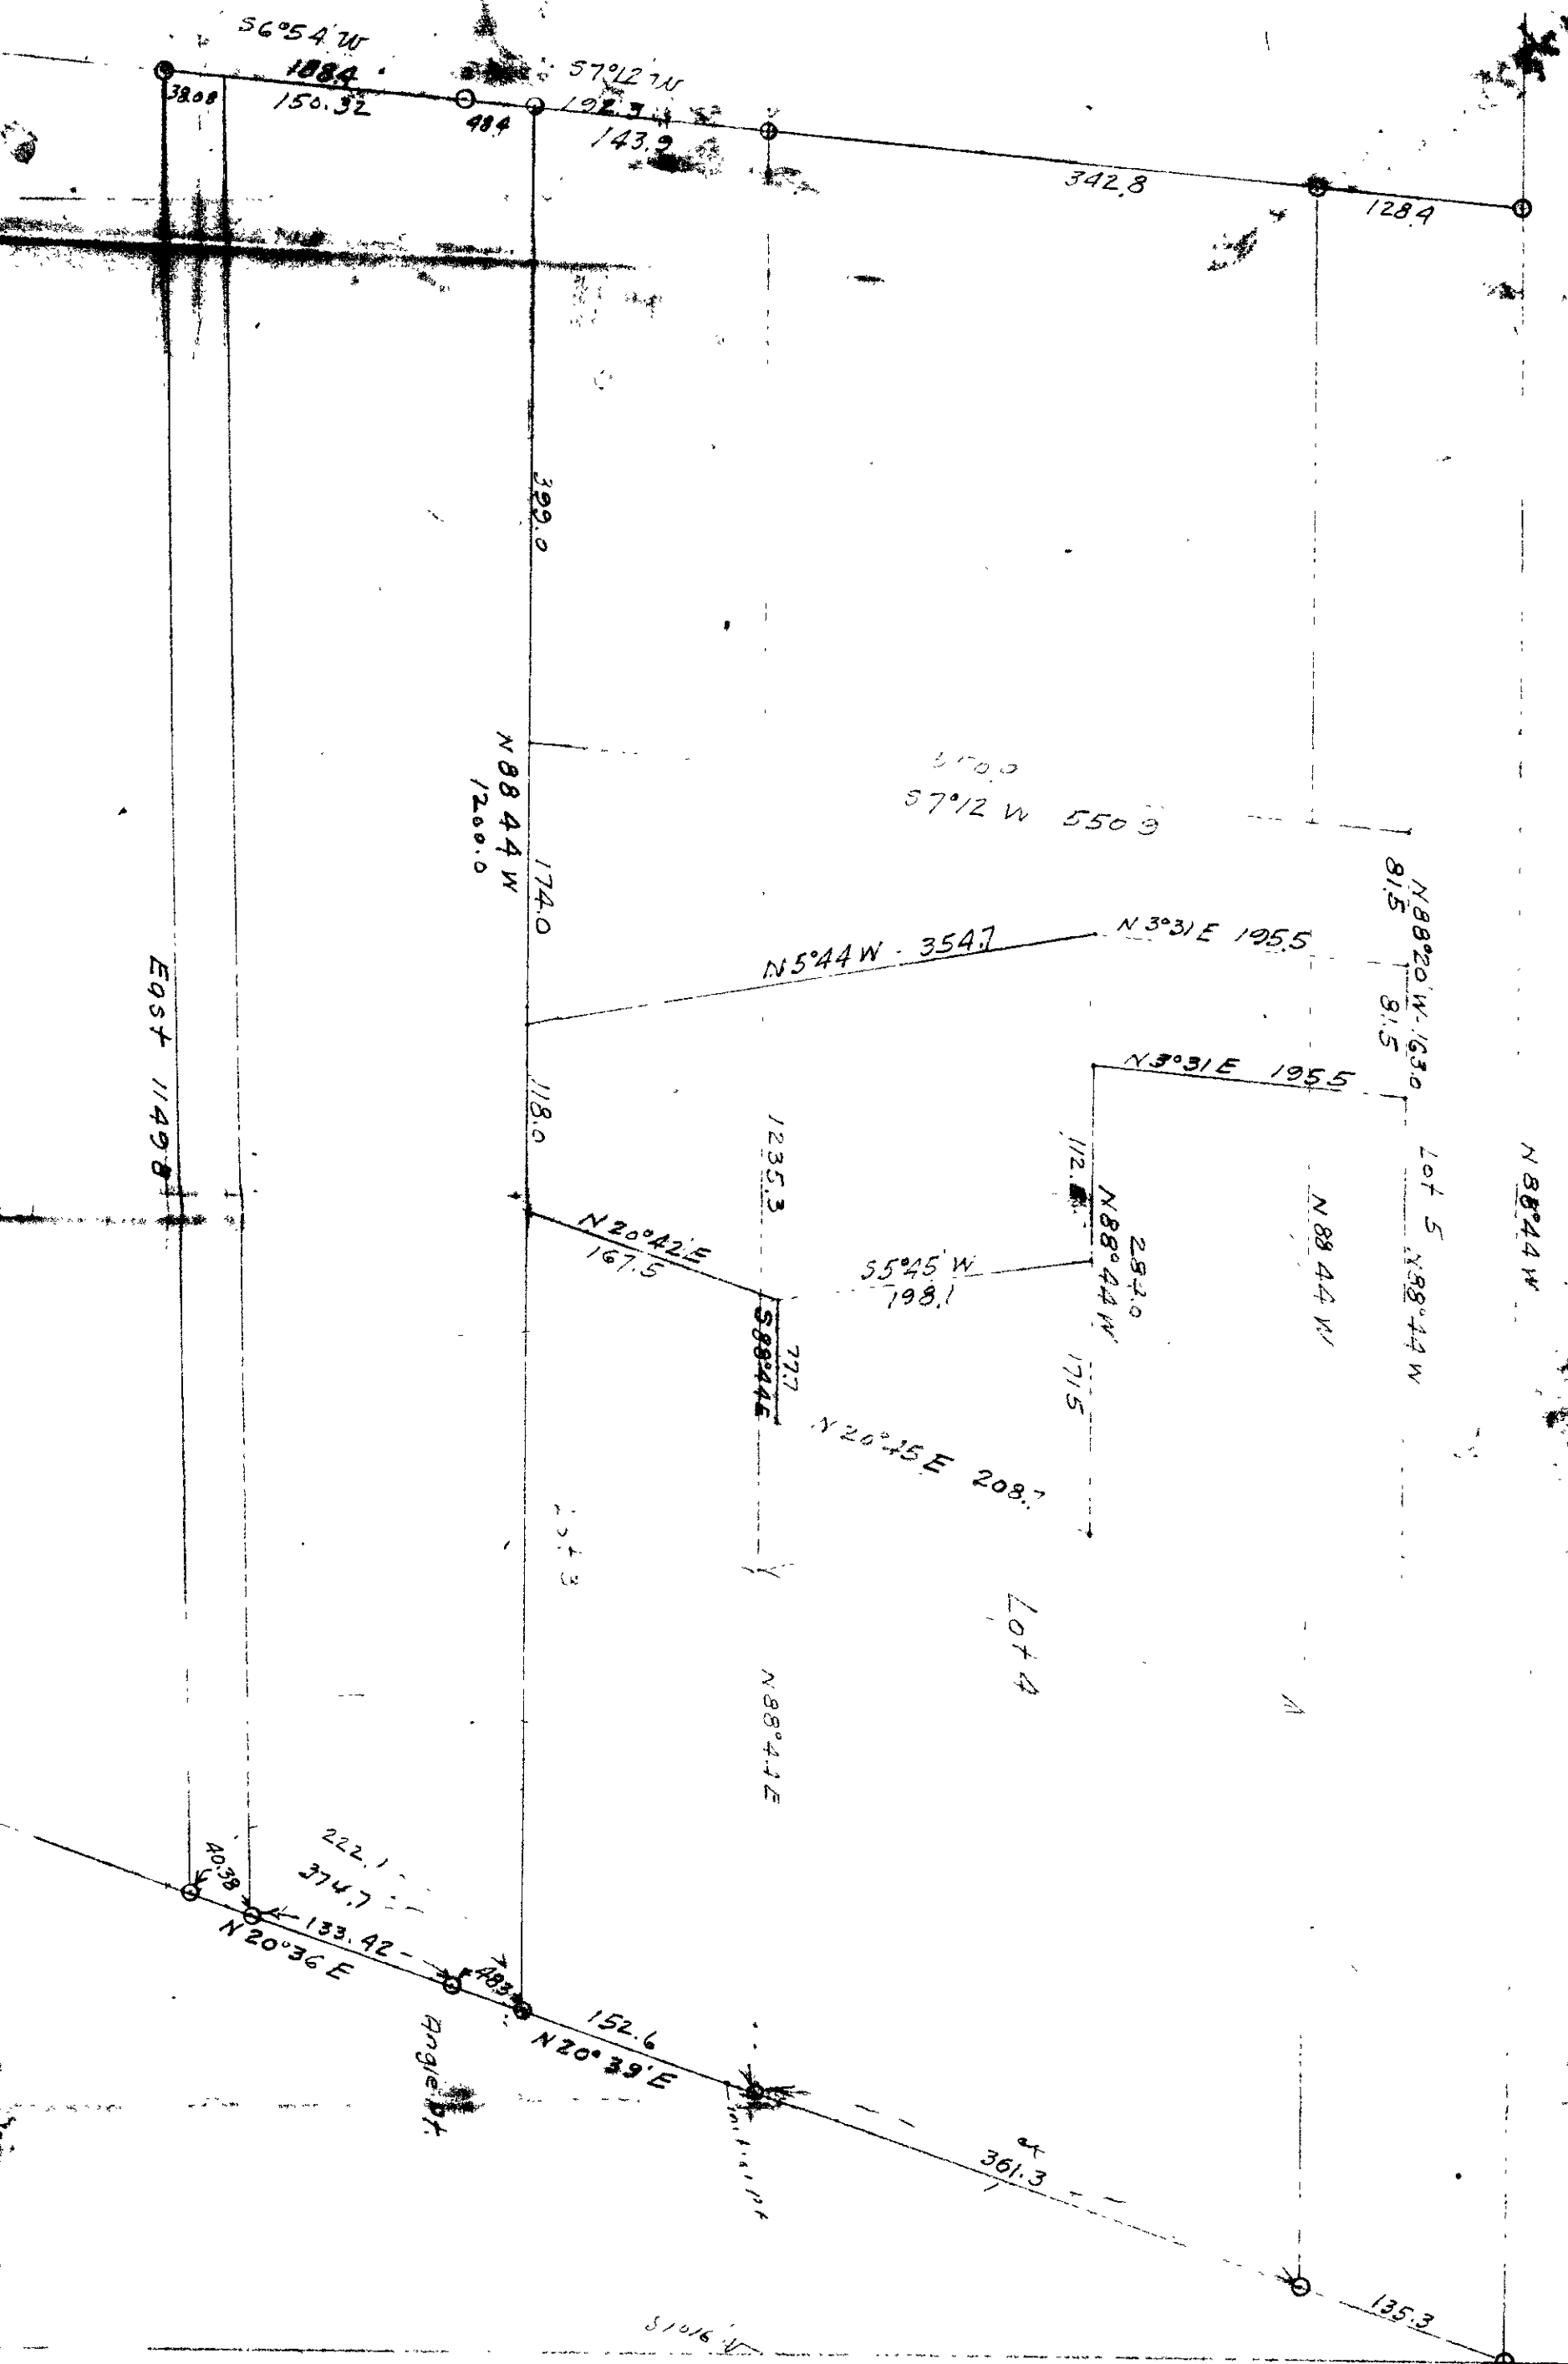

Survey for HOMER C. NEAL  
by Fred Dow  
1949

Q.S. FILE NO. 5049