
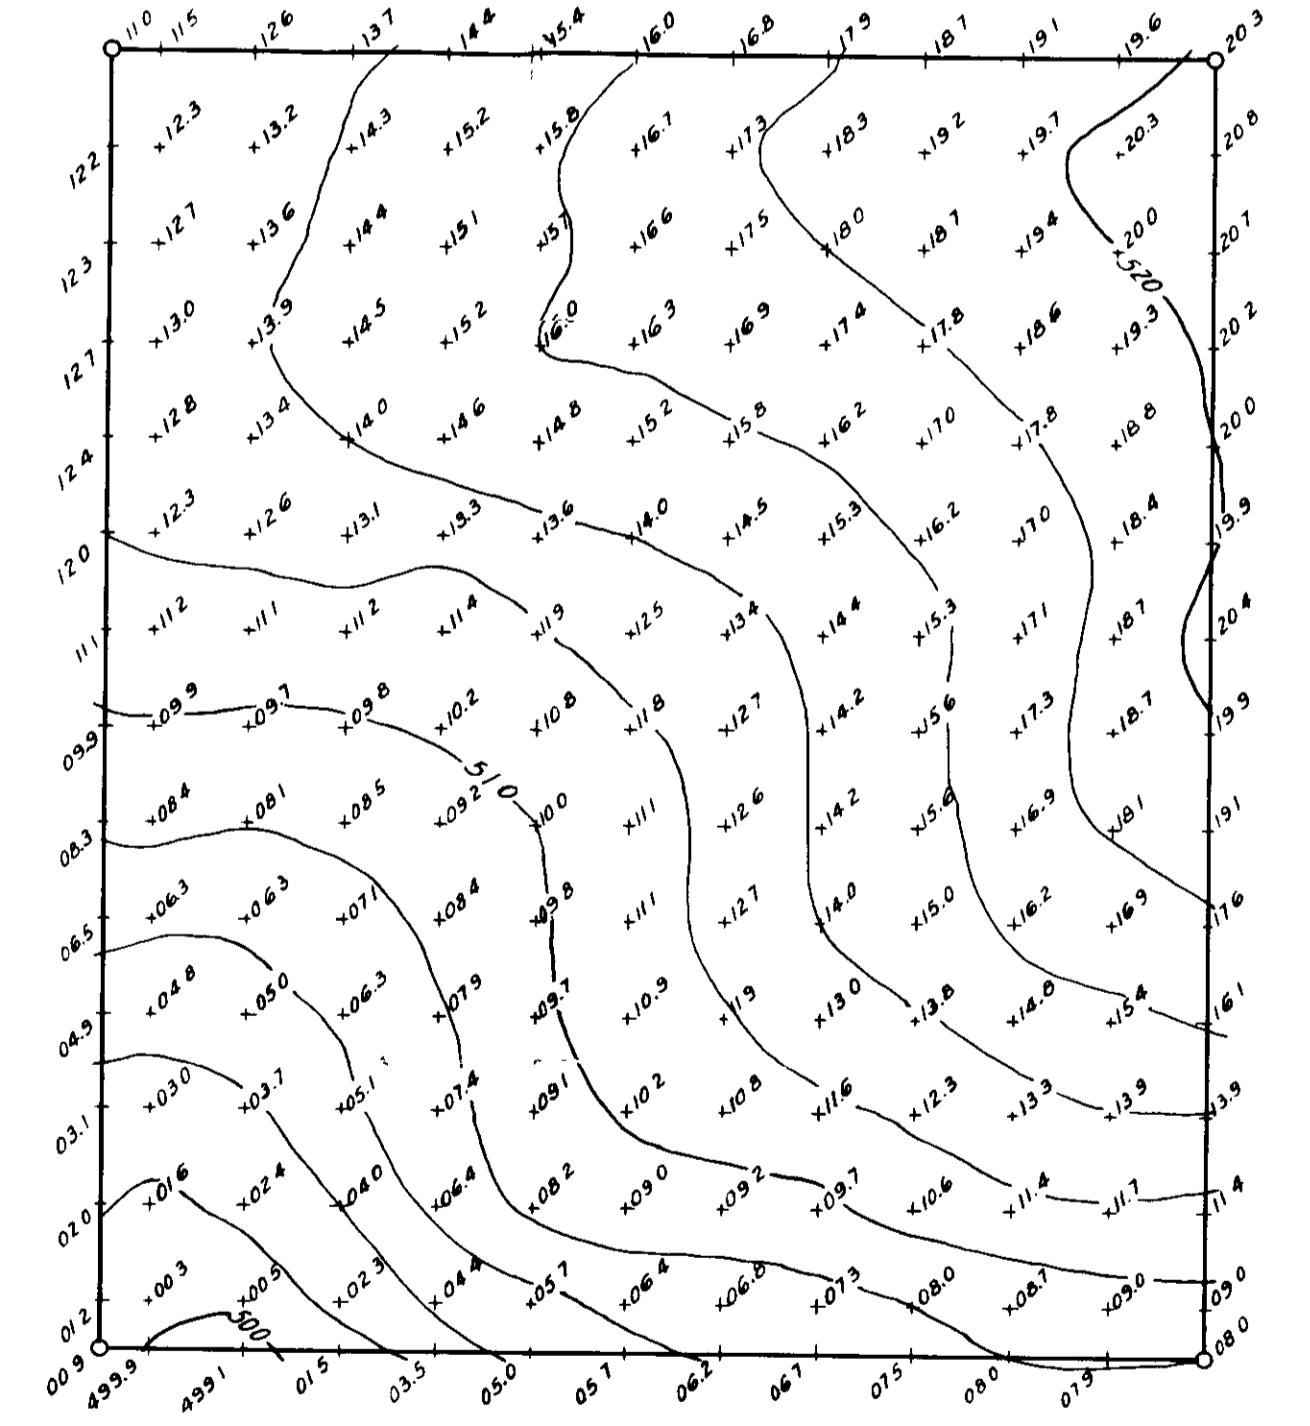


O-49, 181, 182, 183, 999, 1000.

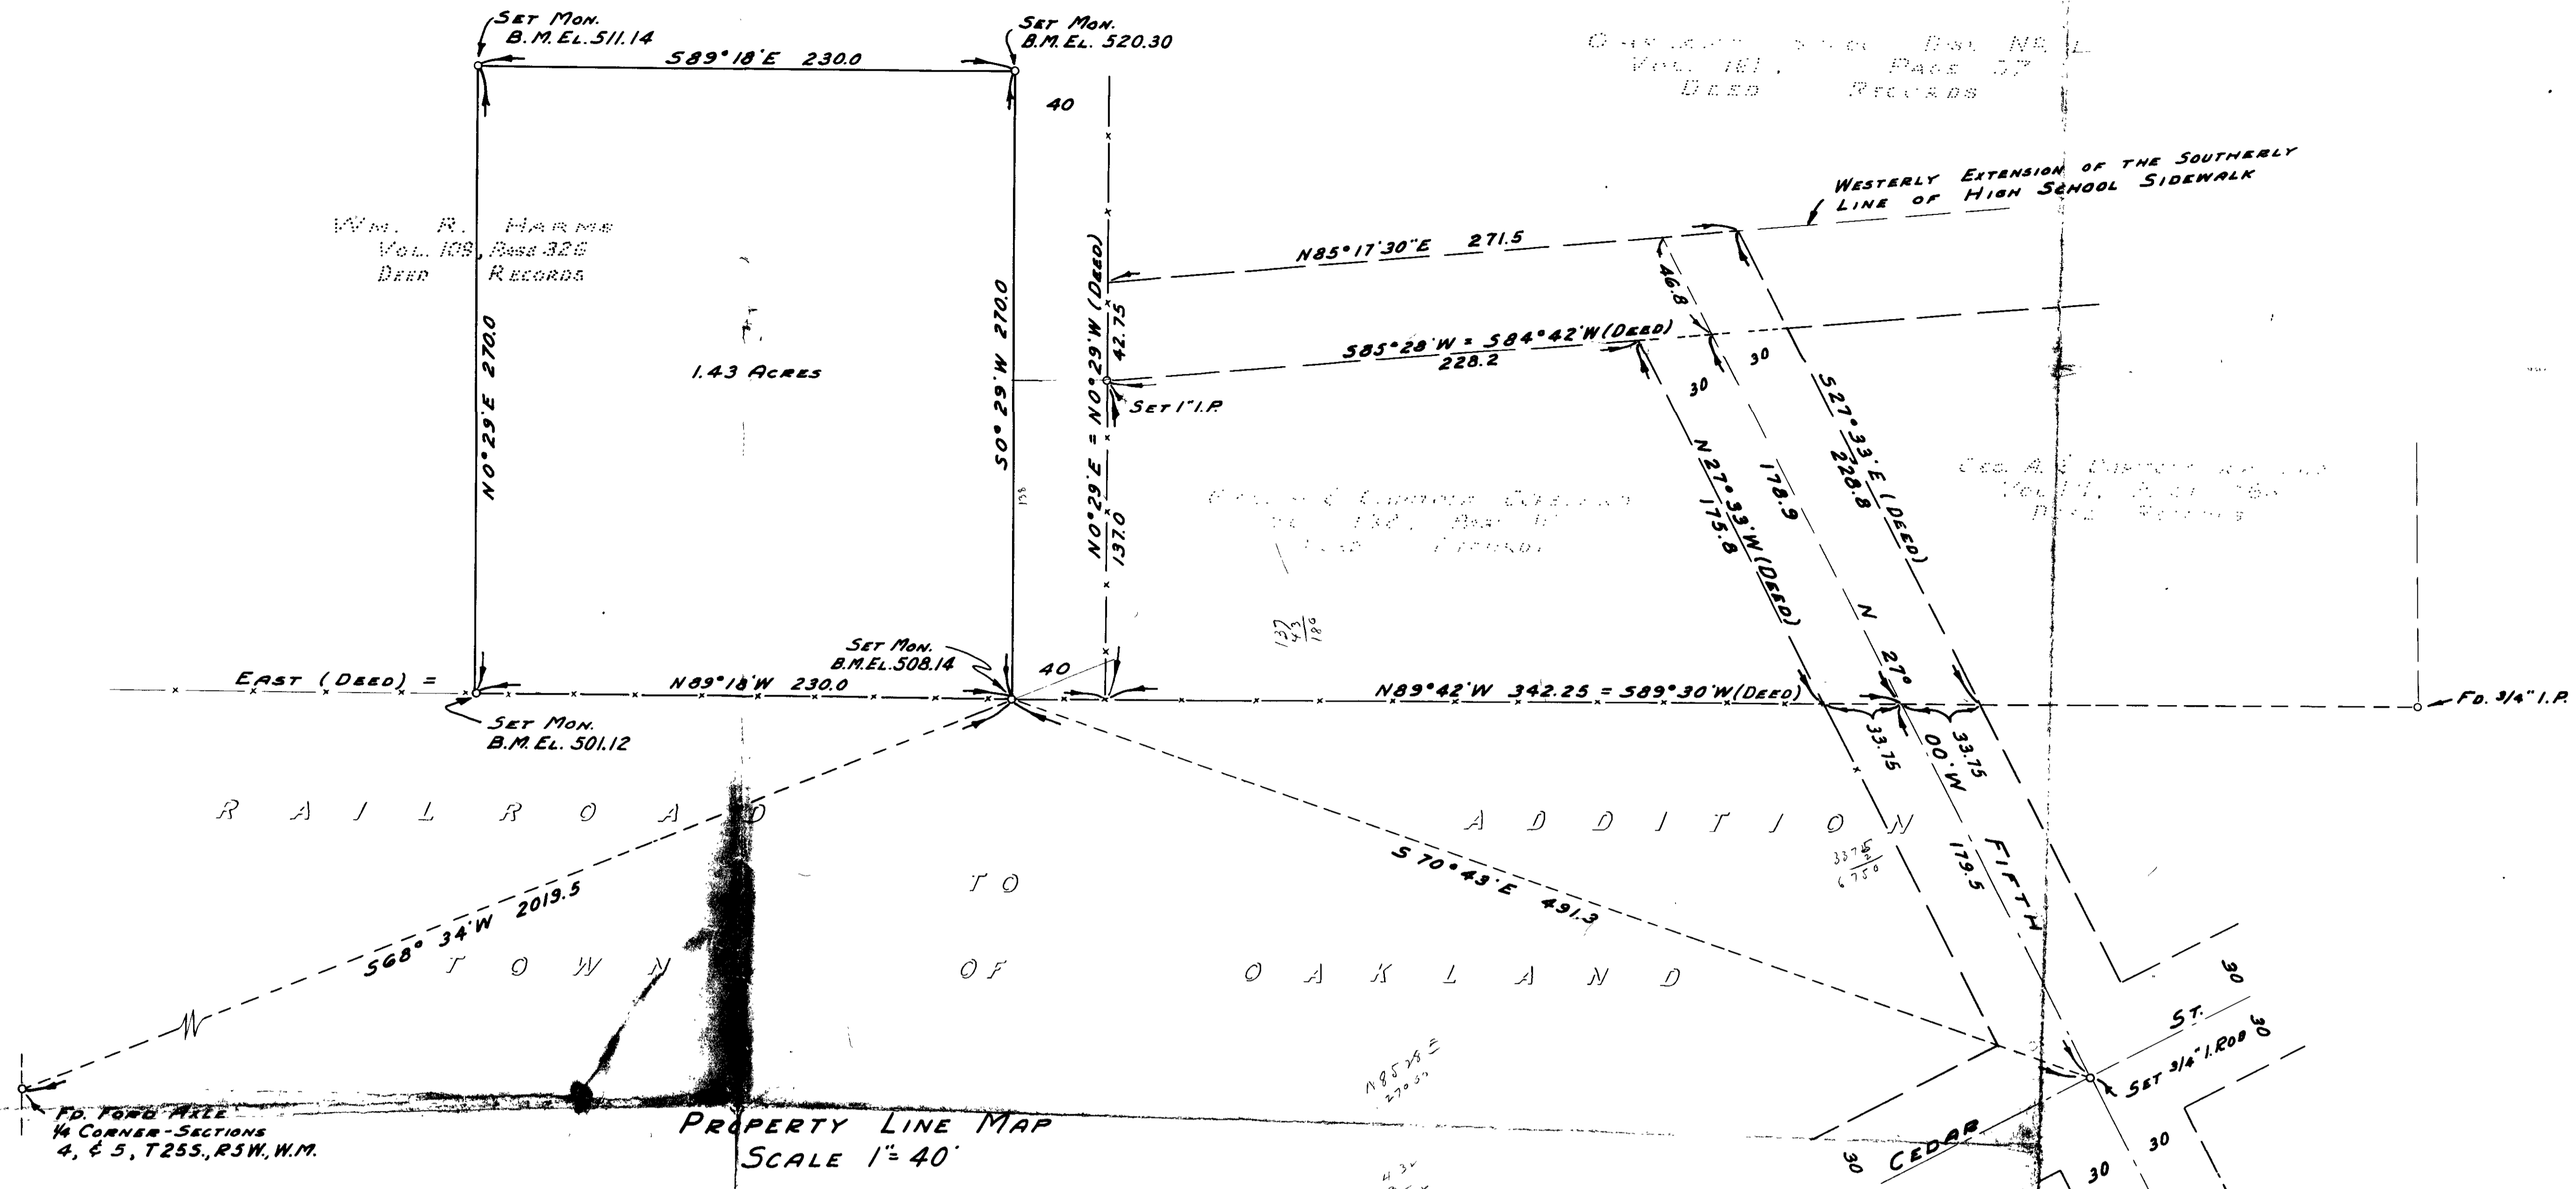

TOPOGRAPHIC MAP
SCALE 1"=40'

NOTE -
ADD 500 TO DATA SHOWN THUS 075
FOR COMPLETE ELEVATION.

NOTE -
BEARINGS SHOWN ARE BASED ON THE BEARING
OF 5 27' 00" E ON THE CENTER LINE OF
RAILROAD ADDITION TO TOWN OF OAKLAND AS FILED
AND RECORDED IN COUNTY CLERK'S OFFICE.
ELEVATIONS SHOWN ARE BASED ON U.S.G.S. B.M. NO.
3-429-L10, ELEV 429.56', LOCATED NEAR SOUTHERN PACIFIC
R.R. CO. DEPOT.
MON. = MONUMENT, CONSISTING OF 1/4" x 3" BRASS ROD SET IN
6" x 36" CONCRETE POST.

**PROPERTY LINE MAP
TOPOGRAPHIC MAP
OAKLAND (ORE. 3-4)**

THE HOUSING AUTHORITY OF DOUGLAS CO., ORE.
ROSEBURG, DOUGLAS COUNTY, OREGON.

BEN. B. IRVING REG. PROF. ENGR.

SCALE 1"=40'

APRIL 12, 1951 PROJECT NO. ORE.3-4
PLAN NO. 1 OF 1