

GEORGE SHAMP PROPERTY

BLOCK 1 PLAT "M"

SUTHERLIN OREGON



SCALE 1"=200'

SURVEYED BY

SEPT. 1948

FRED L. DOW

REGISTERED ENG

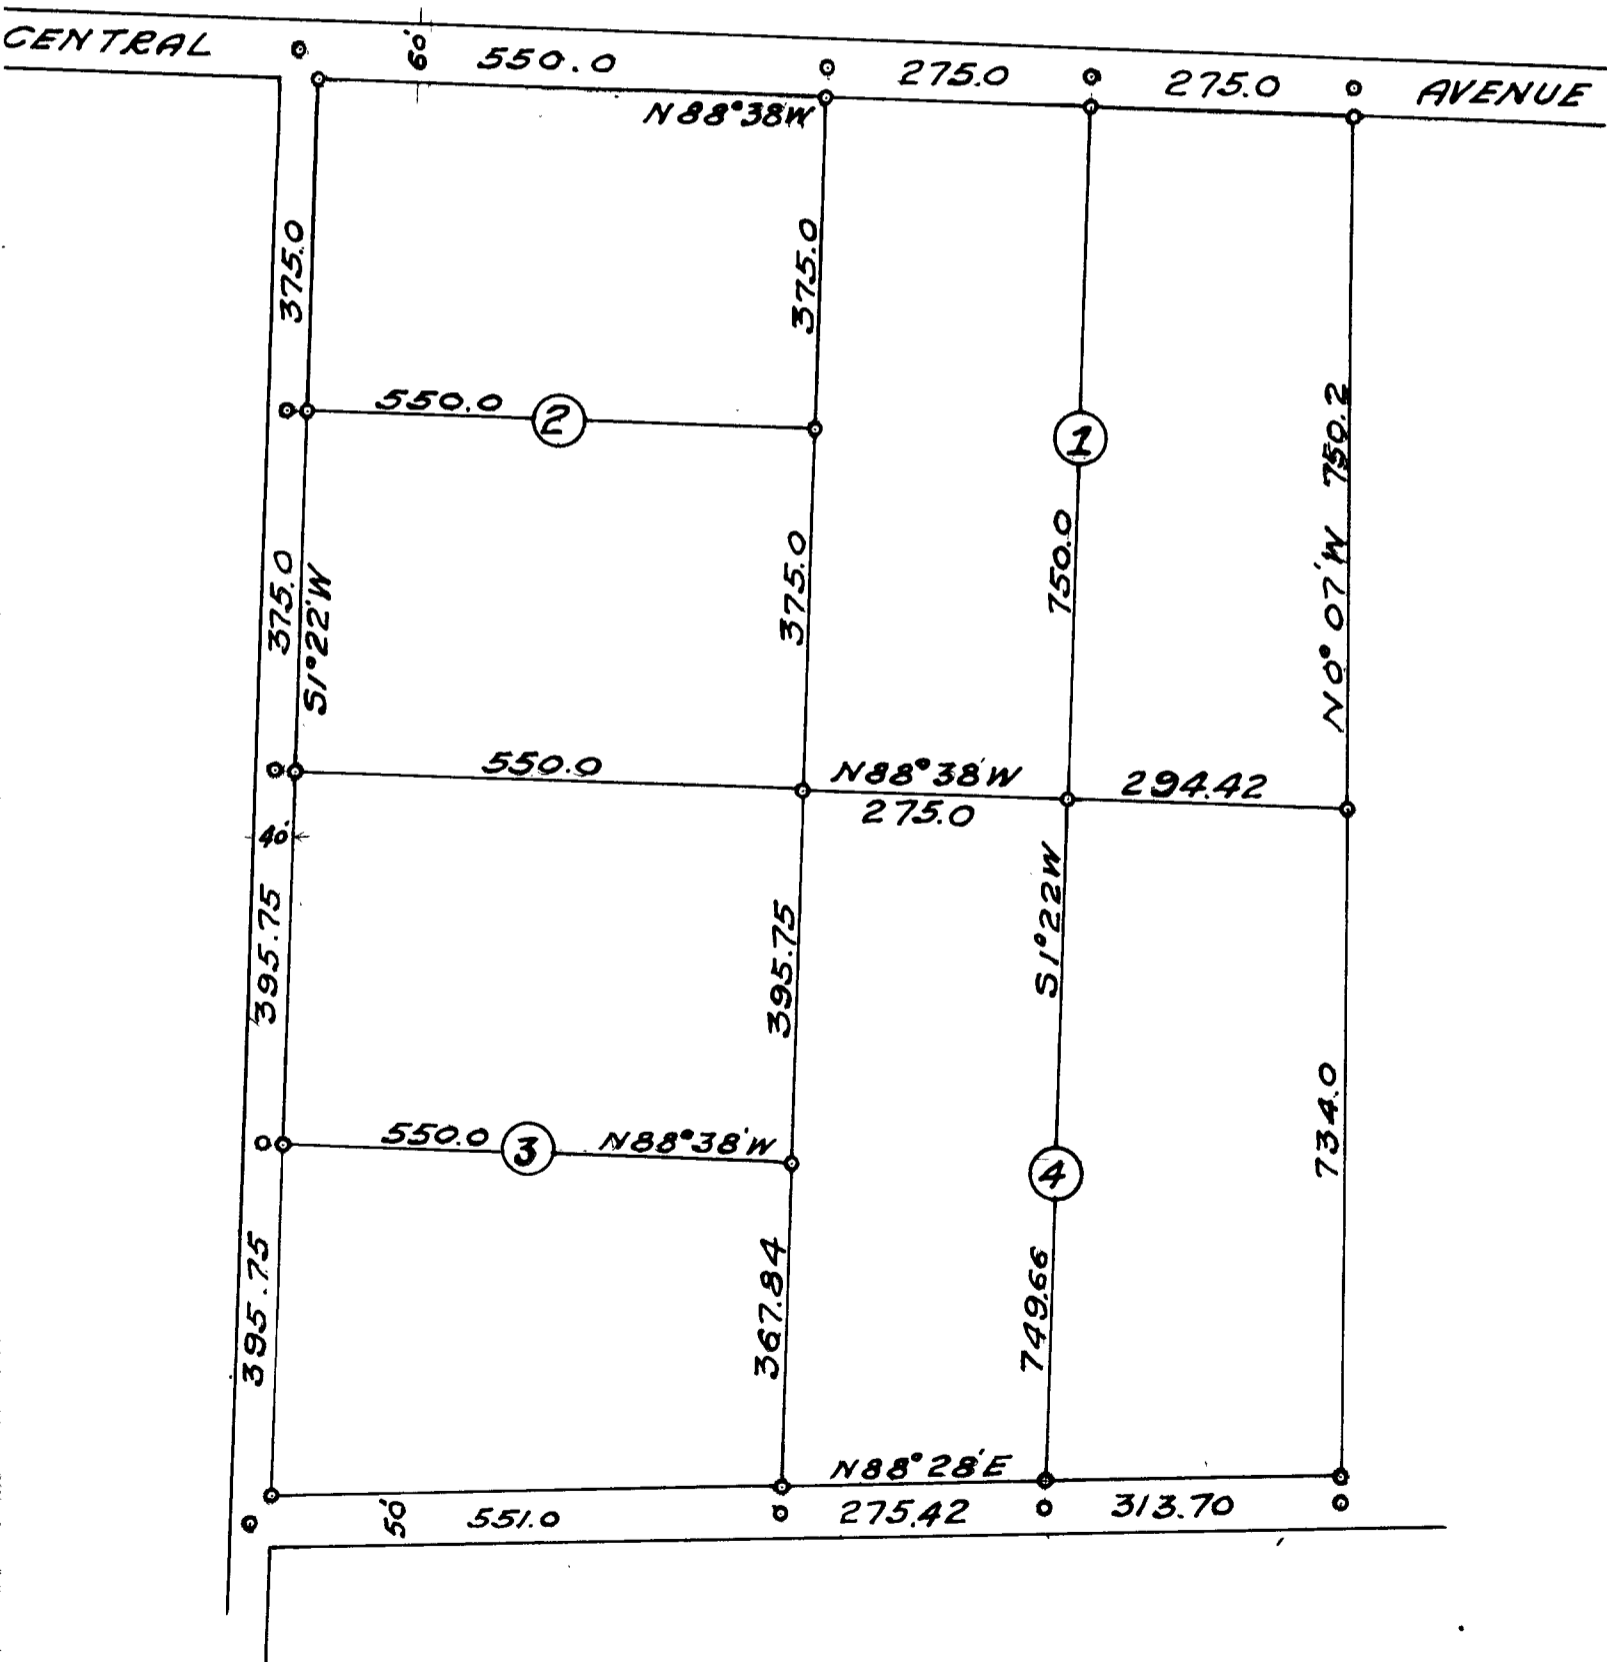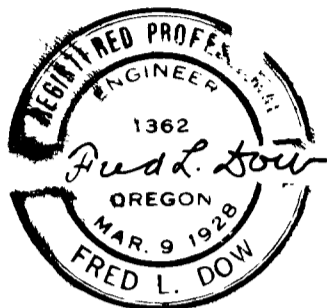

NOTE:

IRON PINS PLACED AT ALL LOT CORNERS

G. S. File No. 50/127