
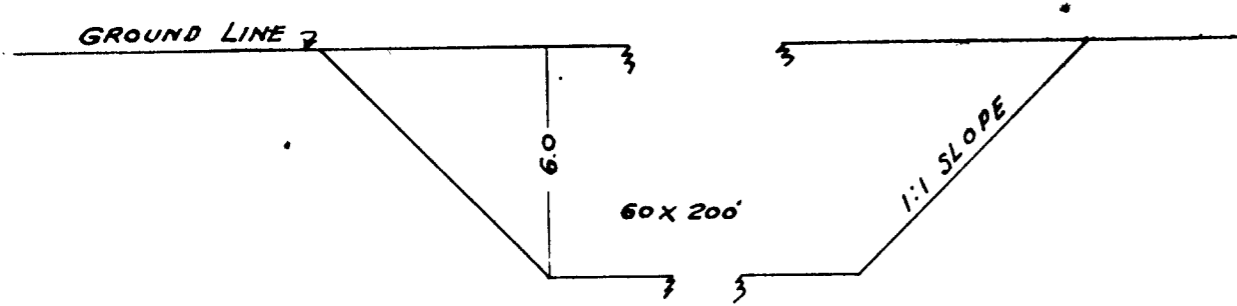
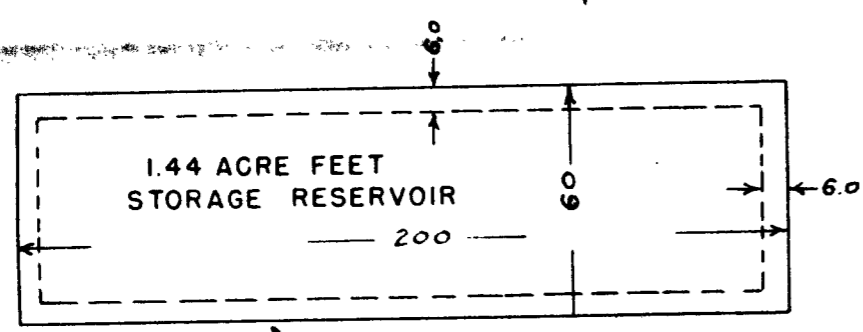


MARION SOUTH
YONCALLA ORE.

N.E. CORNER Wm. J. J. SCOTT D.L.C.

33 T.22S.R.4W.

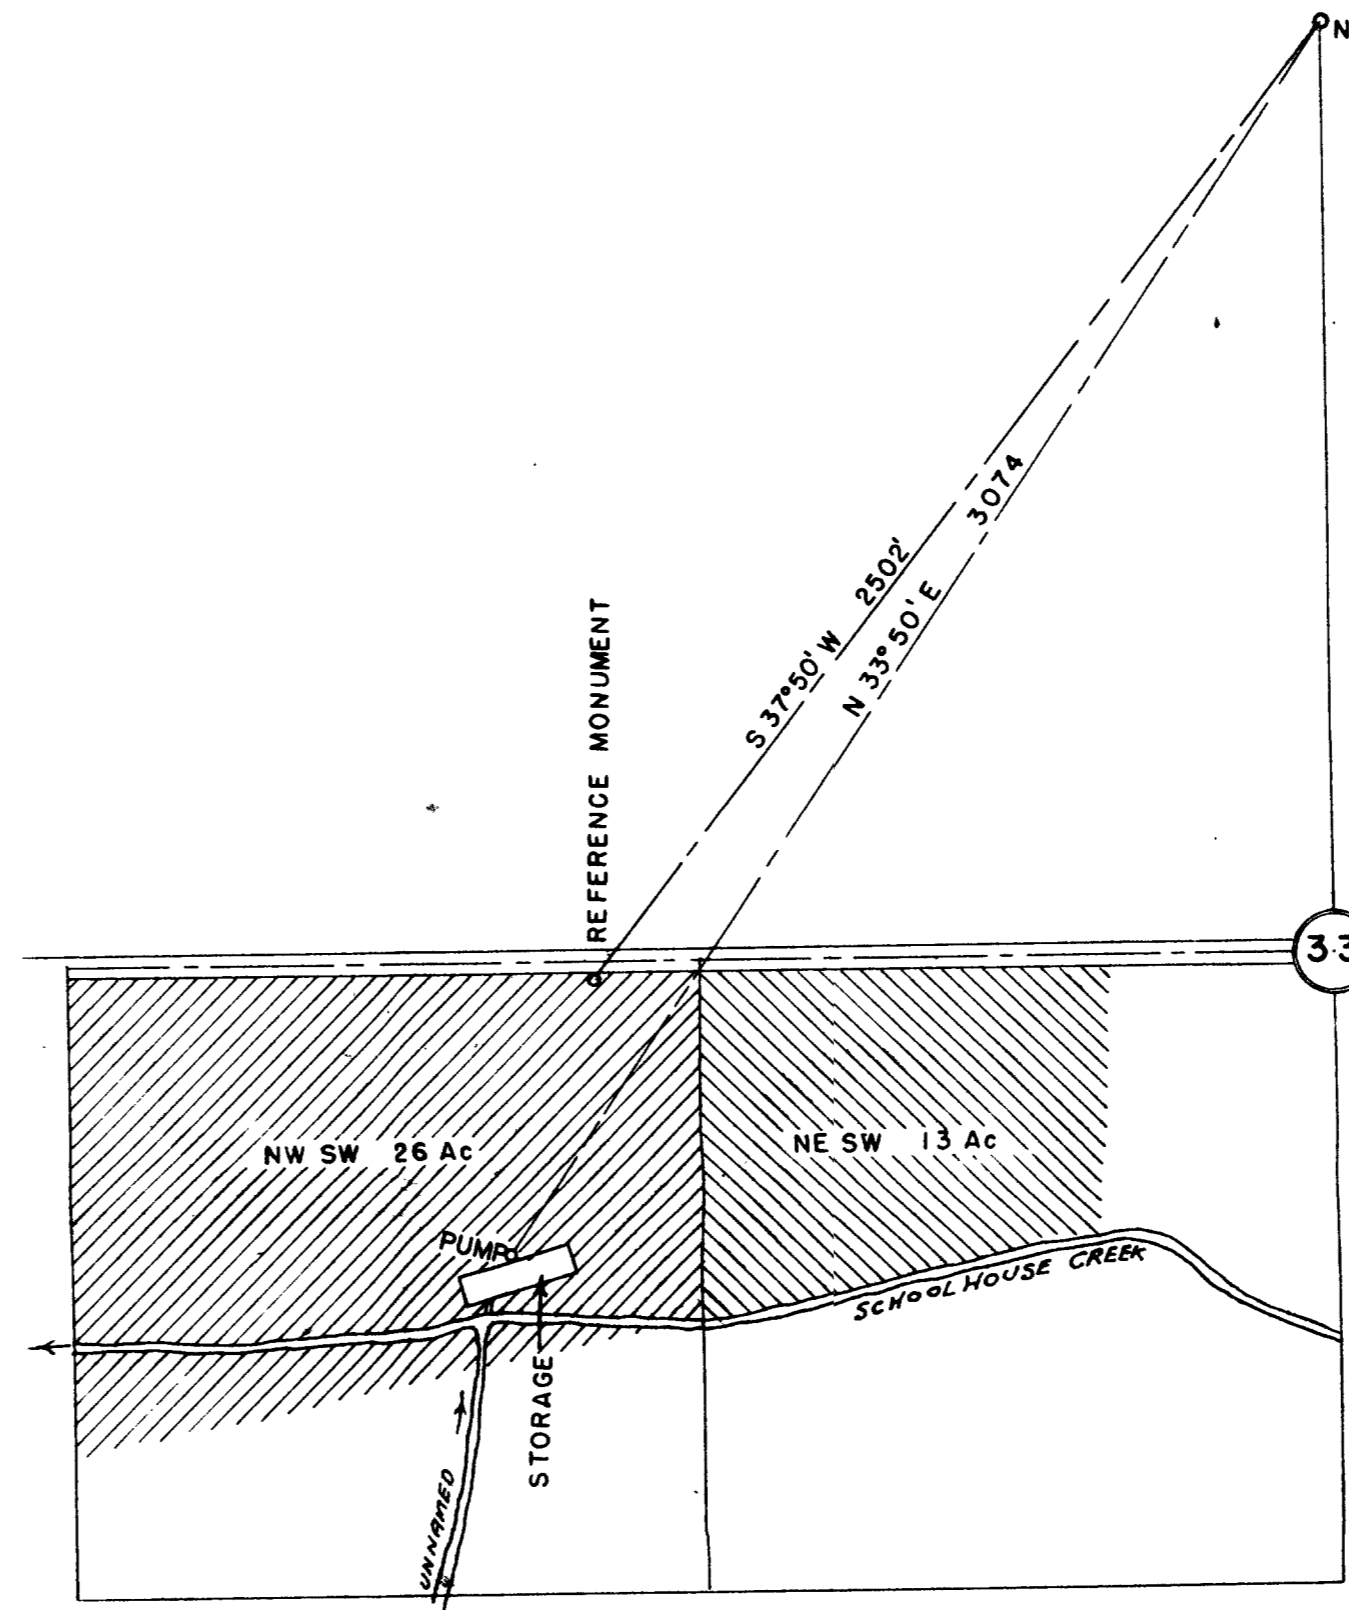

I, FRED L. DOW OF SUTHERLIN, OREGON DO HEREBY CERTIFY THAT THIS MAP WAS MADE FROM NOTES TAKEN DURING AN ACTUAL SURVEY MADE BY ME ON MAY 2, 1952; THAT THE MONUMENT SHOWN ON THIS MAP CONSISTING OF A 1" X 36" IRON PIPE IS S 37°50' W 2502 FEET FROM THE N.E. CORNER OF THE WILLIAM J. J. SCOTT D.L.C.

Fred L. Dow