


STEARNS 2nd ADDITION
 OAKLAND
 NOVEMBER 1956 1" = 40'

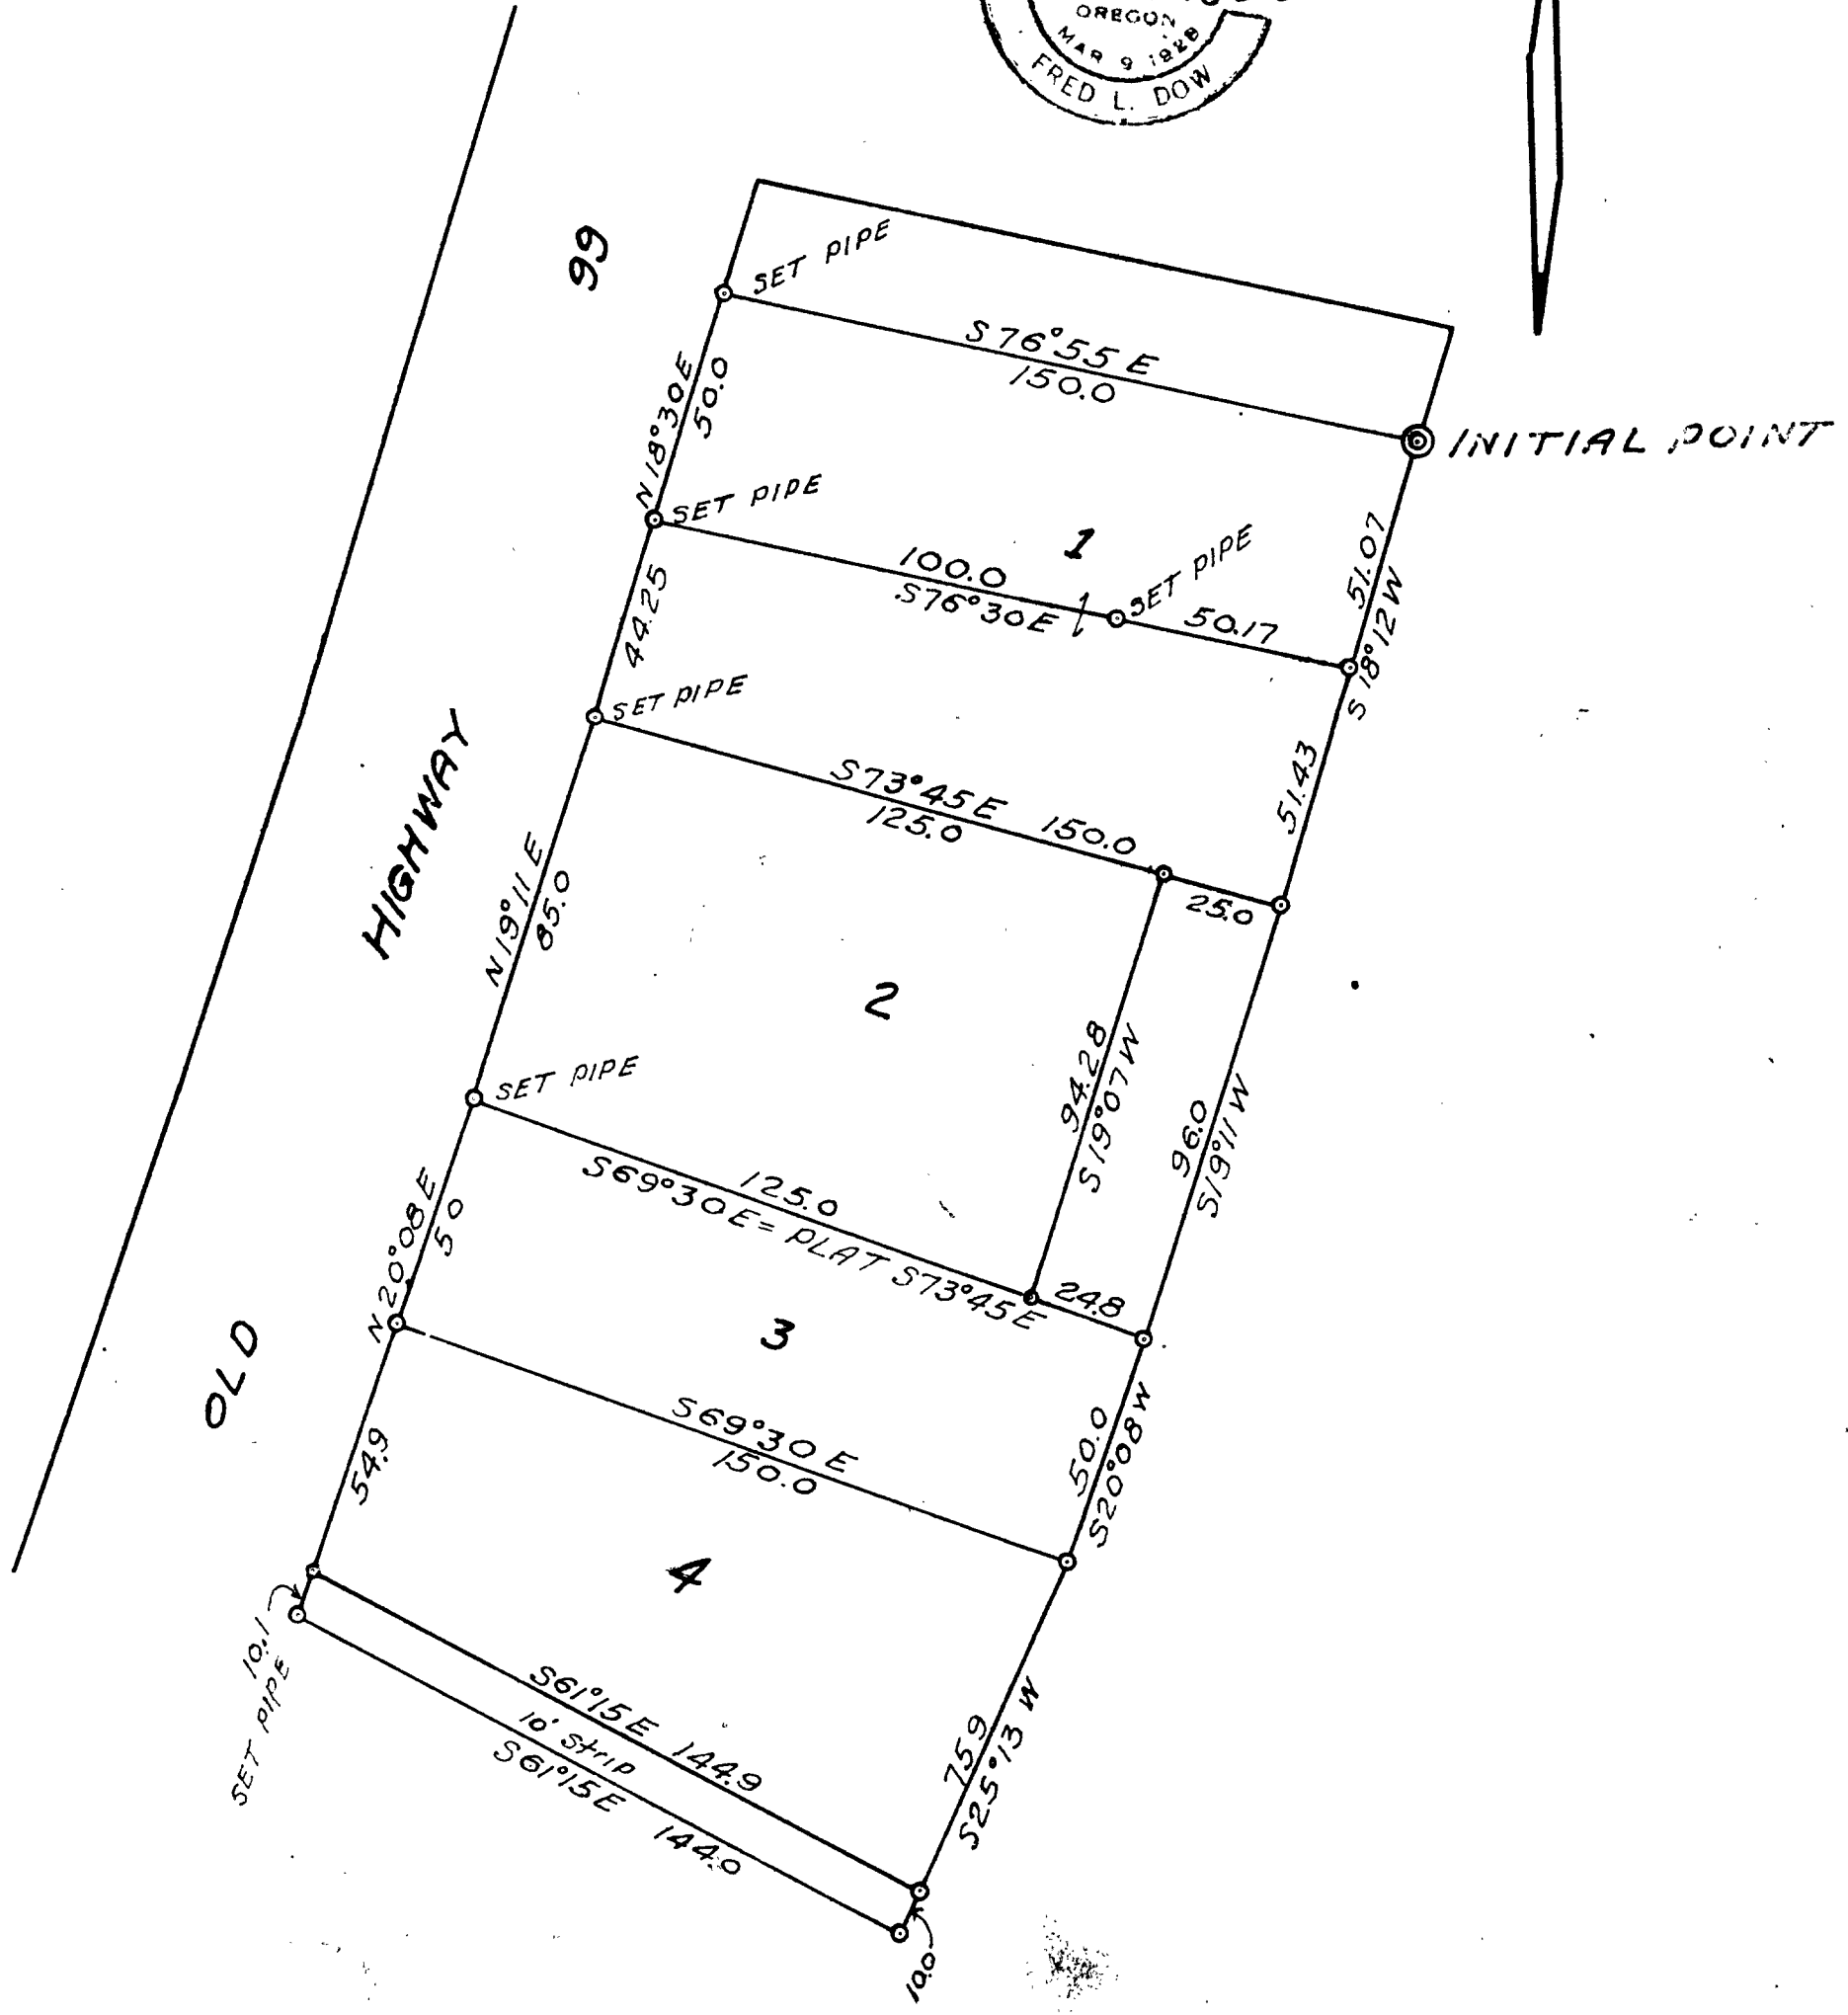

C.S. 50/142-1