


WALTER WILLOUGHBY

SUTHERLIN  
SECTION 18,  
SCALE 1" = 40'

OREGON  
T. 25 S. R. 5 W.  
SEPTEMBER 1954

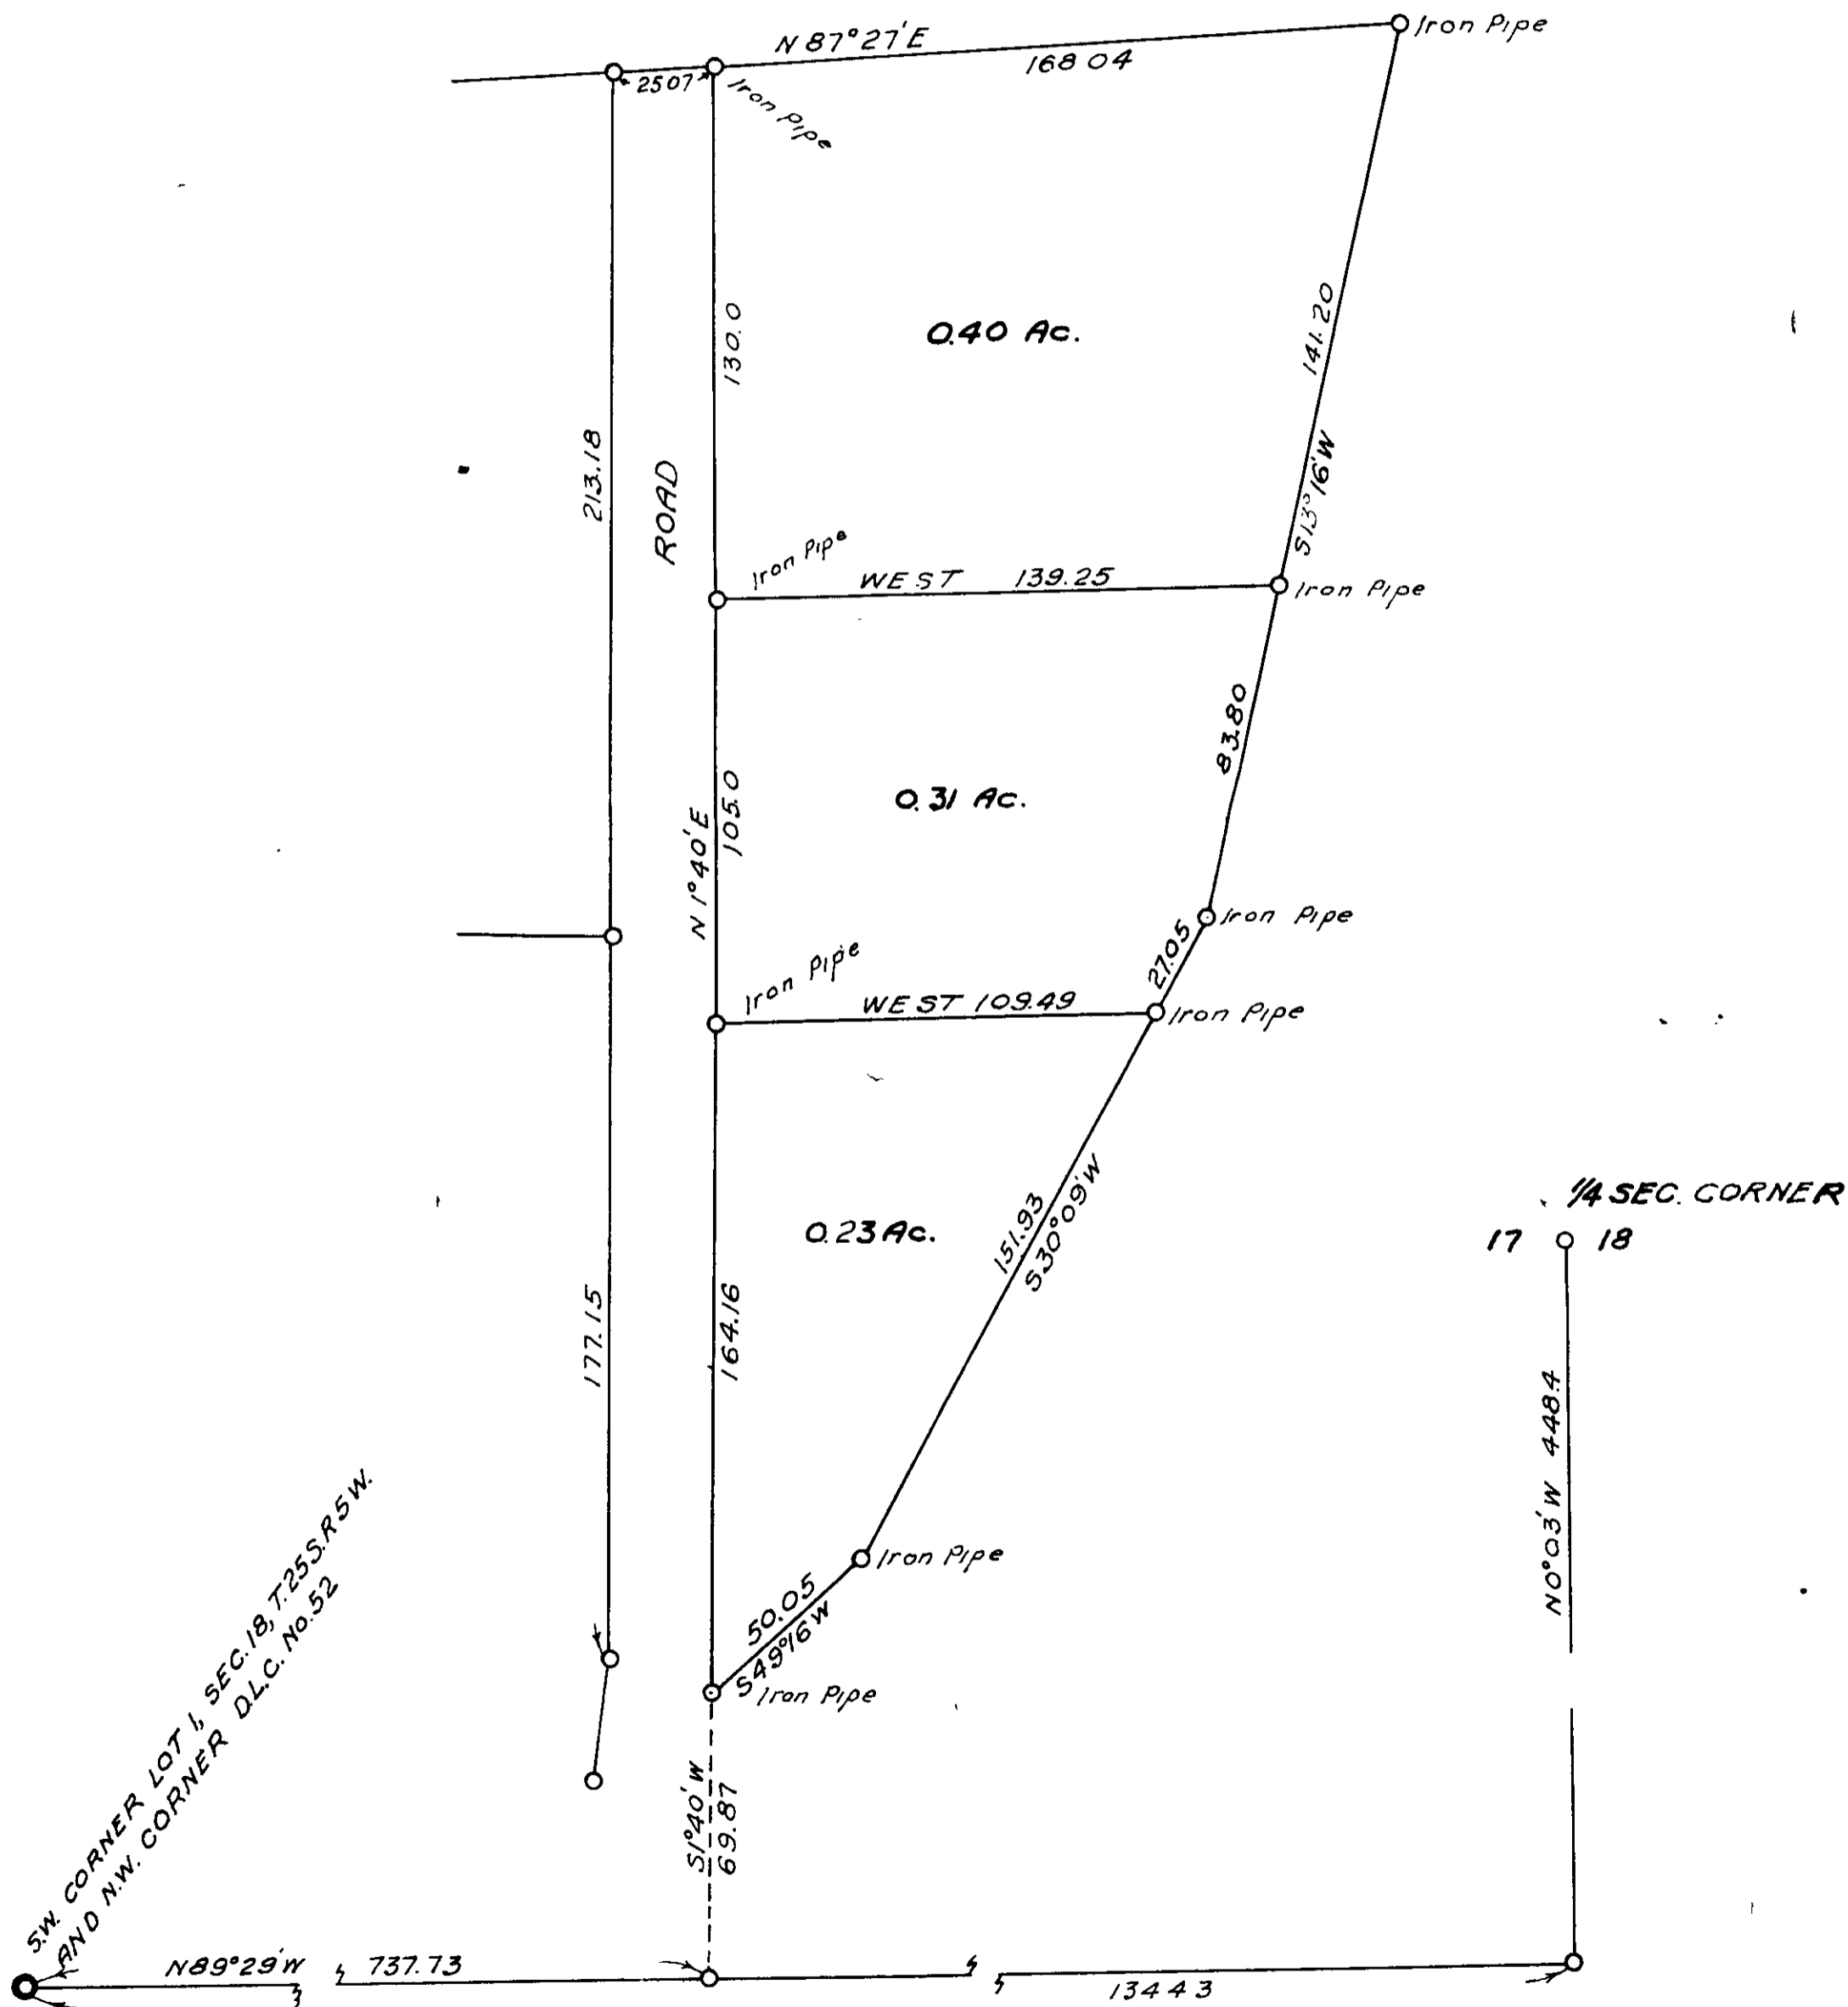

SW CORNER LOT 1, SEC. 18, T. 25 S. R. 5 W.  
AND N.W. CORNER D.L.C. No. 52