
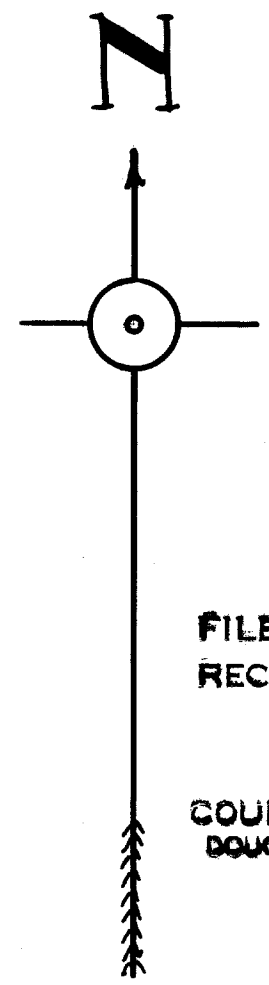
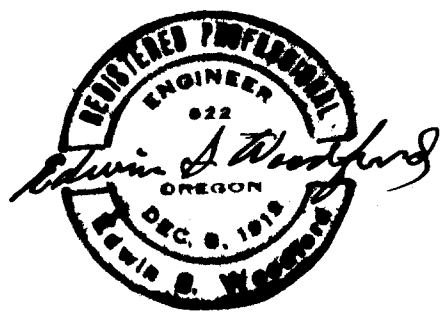


COUNTY SURVEYORS CODE DATA  
 DO NOT REMOVE FROM BOOK

MAP  
 SHOWING LAND SURVEYED  
 FOR  
 FLOYD MITTELSTAEDT  
 IN  
 SEC. 5 - Tp. 30S - Rg. 5W WM.  
 Scale - 1" = 50' - May 1959.

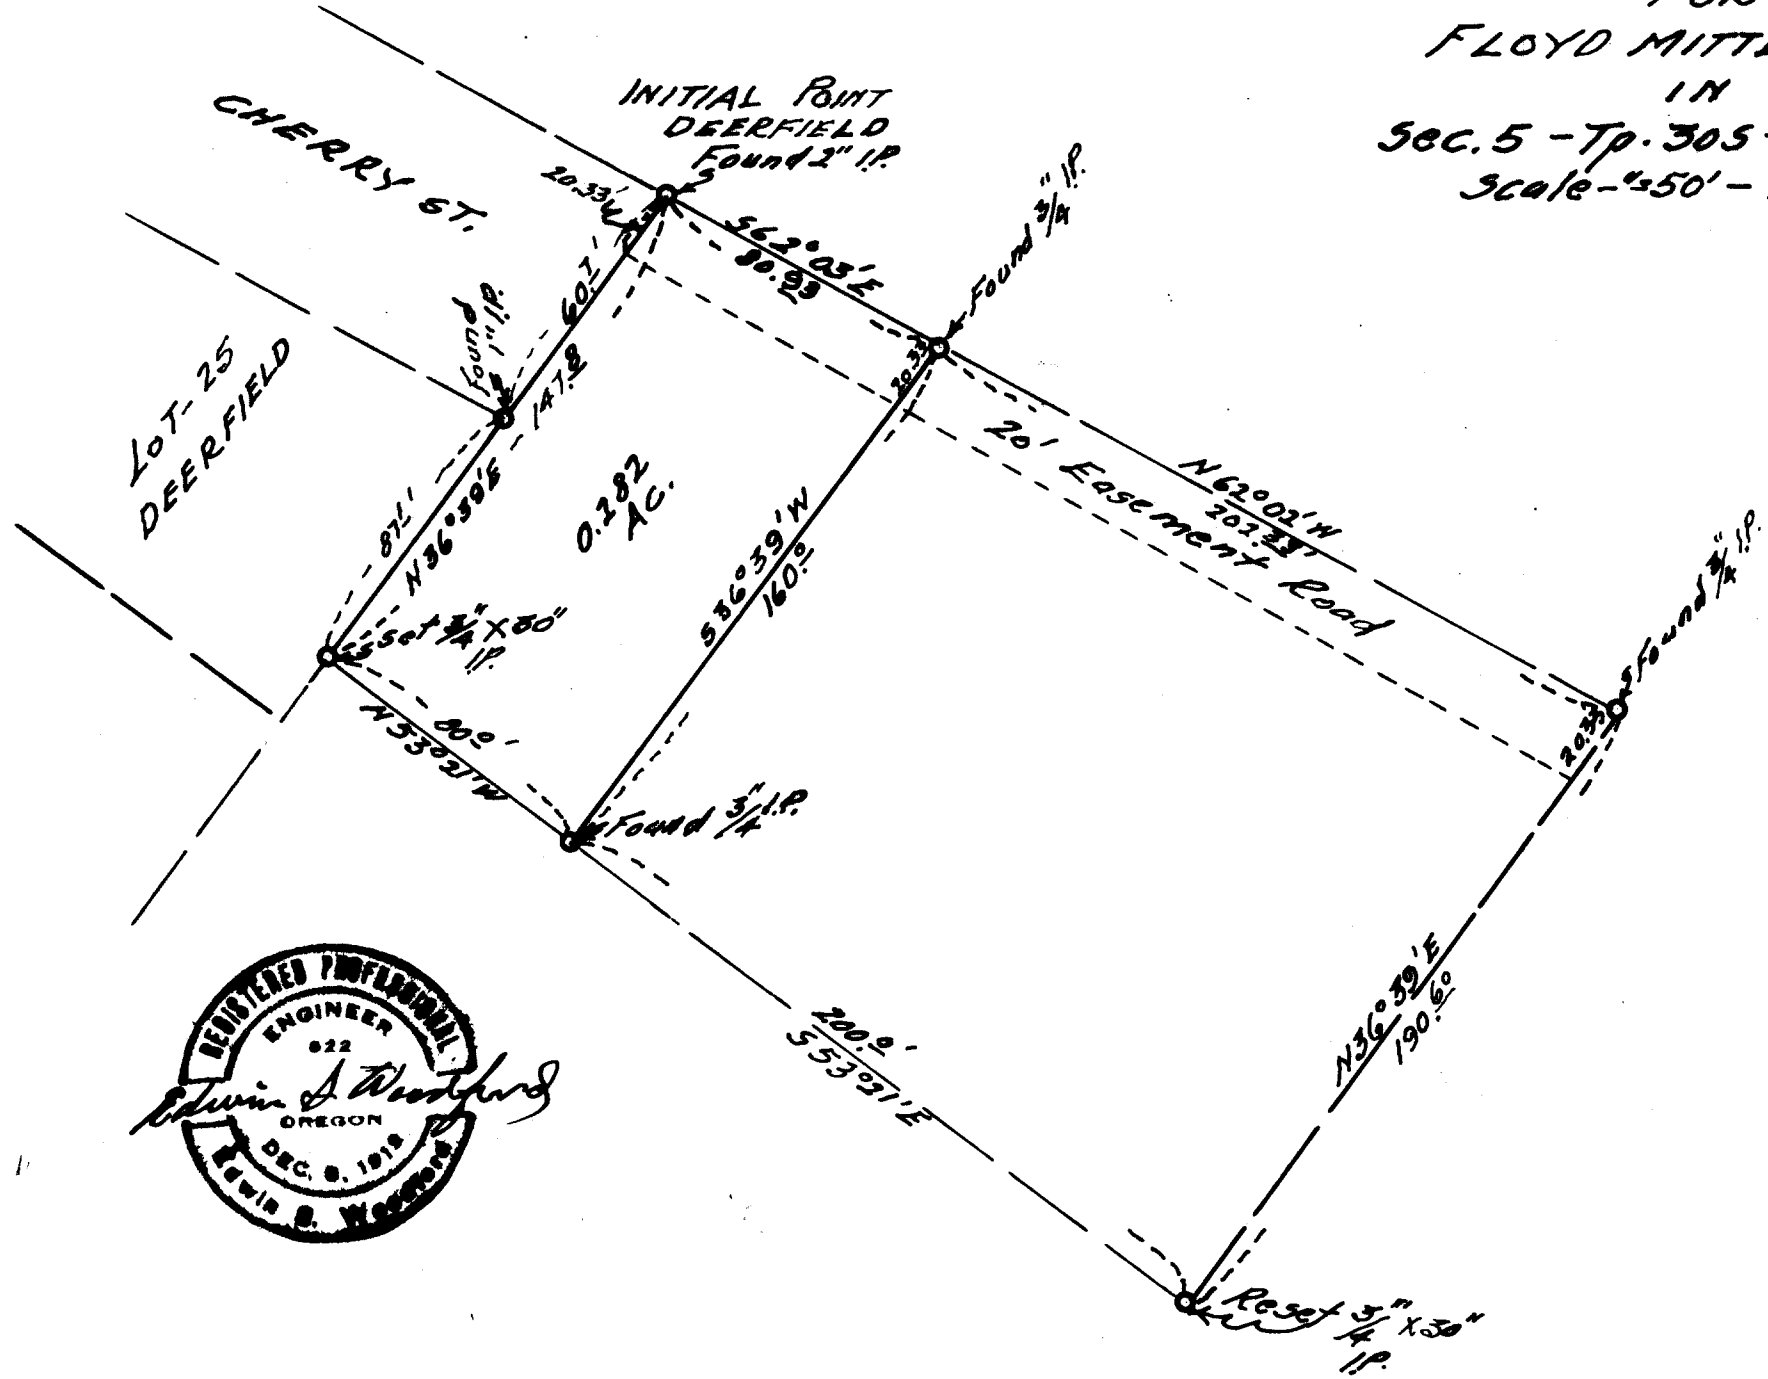

FILED  
 RECEIVED  
 MAY 26 1959  
 COUNTY SURVEYOR  
 DOUGLAS COUNTY, ORE.