

REPLACEMENT OF DAMAGED BEARING TREE


1/4 Corner Sections 14 and 13 Twp. 20 S. -R. 8 W.

Having had a report from the United States Bureau of Land Management Unit Forester that this corner had been damaged in the course of slash burning, I inspected it on June 15, 1959. I found the following:

- (1) A Brass Cap marked
- (2) Section 14 B. T.: A Douglas Fir Stub 3' high  
Approximately 8" DBH (Burnt Down)  
N 72° W 16.9 ft. Distant
- (3) Section 13 B. T.: A Green Douglas Fir, Scorched, But should survive in good shape.  
14" DBH  
S 57° 30' E 34.6 ft. Distant

I replaced the destroyed B. T. by:

A Douglas Fir                      5-1/2" DBH  
 N 10° W                      43.5 ft. Distant  
 Marked: 1/4 S 13 B. T.

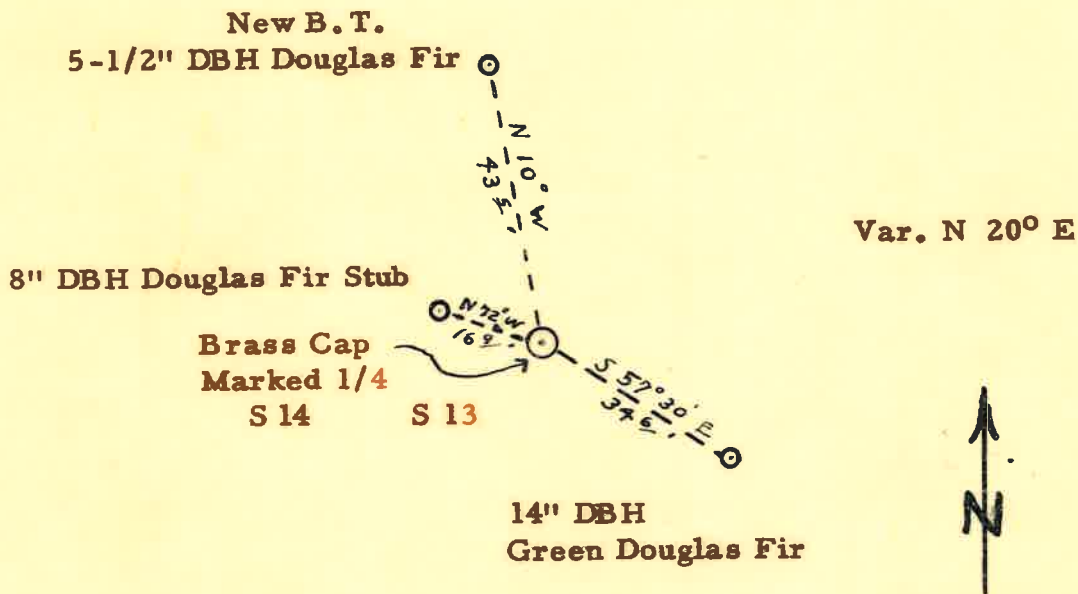

REGISTERED  
 OREGON  
 LAND SURVEYOR  
*John M. Phillips*  
 NOV. 6, 1953  
 JOHN MORRISON PHILLIPS  
 307

June 18, 1959  
Scale 1" = 30'

FILED  
RECEIVED

JUN 22 1959

COUNTY SURVEYOR  
DOUGLAS COUNTY, ORE.