

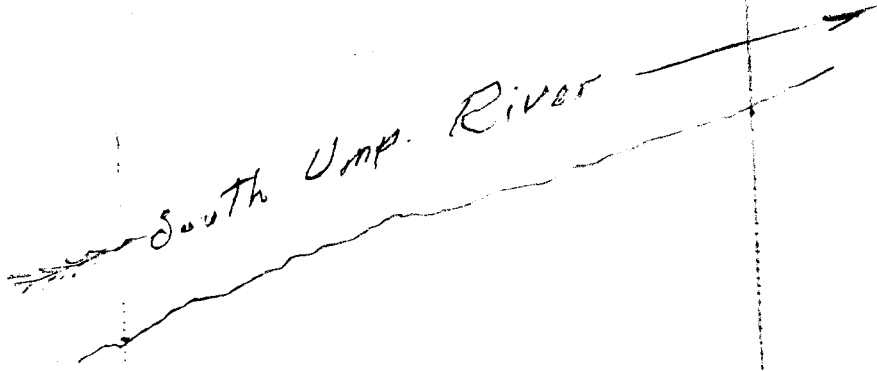


MAP  
 SHOWING LOCATION  
 OF  
 NEIL KASER RESIDENCE  
 ON  
 Lot 1 Block 3  
 of  
 WHAETON ACRES

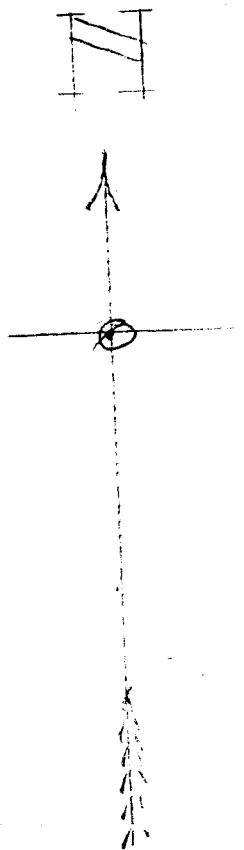

This is to certify  
 that I have checked  
 the location of the  
 NEIL KASER Residence  
 on the ground and  
 found the same to  
 be located as shown  
 on the annexed plat.

Signed  
 Edwin A. [Signature]  
 Reg. Prof. Eng.  
 B.A.

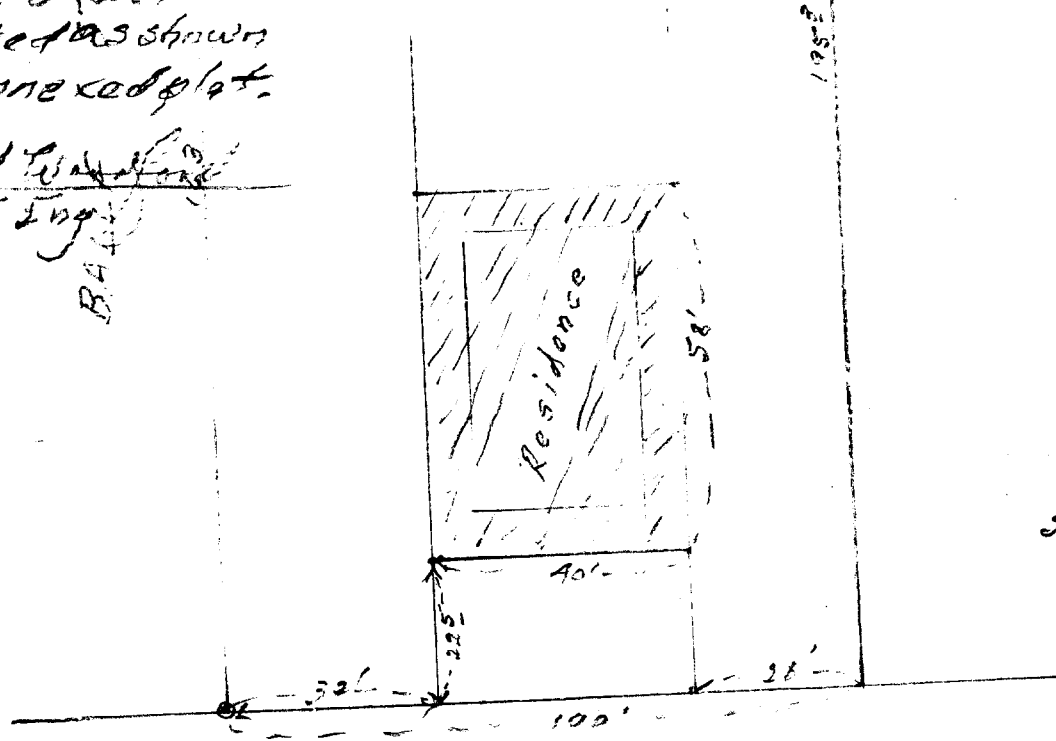

Scale - 1" = 20'

NEILL ST.  
 (T 27-6-13 SW 1/4)