


DO NOT REMOVE FROM OFFICE

T. 26 S., R. 8 W., WILLAMETTE MERIDIAN, OREGON

DEPENDENT RESURVEY

LINE BETWEEN SECTIONS 27 AND 28

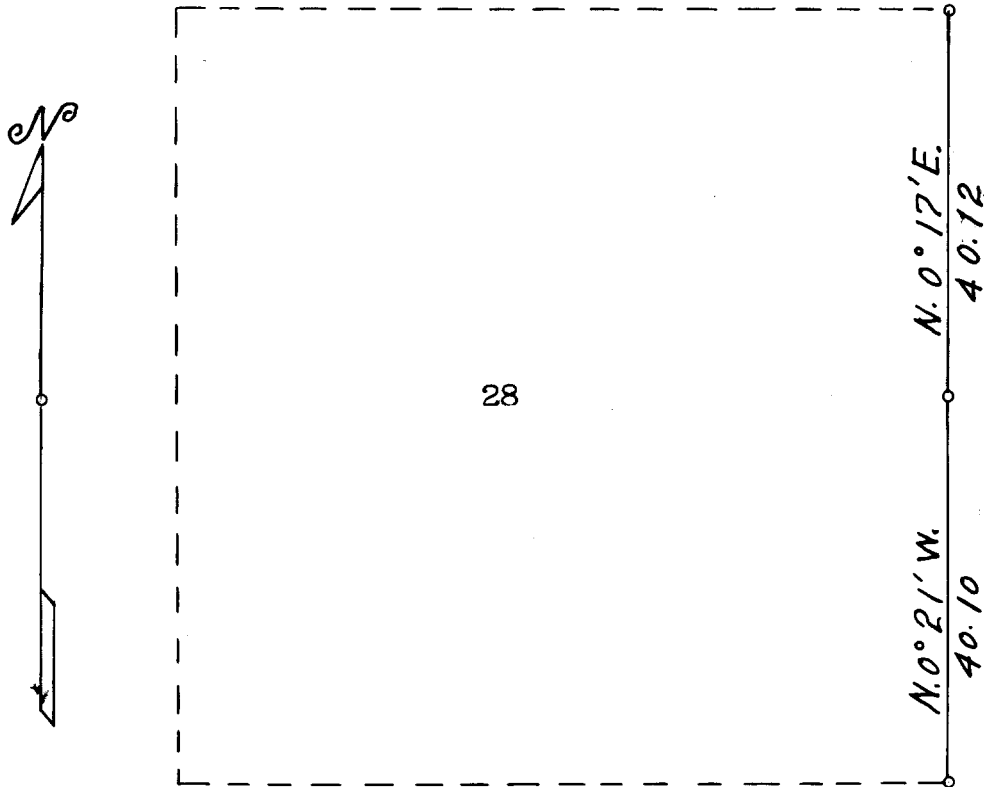

Scale: 1 in. = 20 chains = 1320 ft.

Mean Magnetic Declination 20° 31' E.

The bearings of all lines are referred to the true meridian determined by solar observations.

● = Corner Occupied and monumented.

— Line Surveyed - - - - - Line Not Retraced.

Survey executed July 30 - August 6, 1959, for

J. H. Baxter & Company of Grants Pass, Oregon.

I hereby certify that the survey represented by this plat is executed in conformity with the Laws of the State of Oregon.

Mervin O. Ramsey

FILED *LL*
RECEIVED

AUG 20 1959

COUNTY SURVEYOR
DOUGLAS COUNTY, ORE.

C. S. File No. 51/41-1A

TOWNSHIP 26 SOUTH, RANGE 8 WEST, WILLAMETTE MERIDIAN, OREGON
DEPENDENT RESURVEY
OF
SECTION LINE BETWEEN SECTIONS 27 AND 28

EXECUTED AT THE REQUEST OF J. H. BAXTER & COMPANY
OF
GRANTS PASS, OREGON
BY

Marvin C. Ramsey, Registered Professional Land Surveyor.

Survey commenced July 30, 1959

Survey completed August 6, 1959

FILED
RECEIVED

AUG 27 1959

COUNTY SURVEYOR
DOUGLAS COUNTY, ORE.

C. S. File No. 51/41-1b

TOWNSHIP 26 SOUTH, RANGE 8 WEST, WILLAMETTE MER., OREGON

Dependent Resurvey of Line Between Sections 27 & 28.

Chains

The corner of secs. 27, 28, 33, and 34 is determined at the record bearings and distances from the original bearing trees.

At the corner point,

Set an iron pipe, 3 ft. long, 2 ins. diam., 28 ins. in the ground, mkd. RS404; from which the original bearing trees:

A fir snag 30 ins. diam., bears N. 42° E., 57 lks. dist., with partial scribe marks.

A fir snag 36 ins. diam., bears S. 63° E., 60 lks. dist., with partial scribe marks.

A fir snag 40 ins. diam., bears S. 14° E., 134 lks. dist., marks burned out.

A fir snag 36 ins. diam., bears N. 31° W., 58 lks. dist., marks burned out.

New bearing trees

A fir 14 ins. diam., bears N. 12° E., 44 lks. dist., mkd. T26S R8W S27 RS404 BT.

A fir 16 ins. diam., bears S. $69\frac{1}{2}^{\circ}$ E., 47 lks. dist., mkd. T26S R8W S34 RS404 BT.

A fir 12 ins. diam., bears S. $66\frac{1}{2}^{\circ}$ W., $9\frac{1}{2}$ lks. dist., mkd. T26S R8W S33 RS404 BT.

A fir 18 ins. diam., bears N. $10\frac{1}{2}^{\circ}$ W., 63 lks. dist., mkd. T26S R8W S28 RS404 BT. ✓ #4

The geographic position of this sec. cor. is lat. $43^{\circ} 16' 33''$ N., and long. $123^{\circ} 38' 22''$ W. The observed magnetic declination is $20^{\circ} 33'$ E.

July 30, 1959: at this sec. cor. at 8 a.m., by my watch which reads correct 120th meridian time, I set off $43^{\circ} 16\frac{1}{2}'$ N., on the lat. arc, $19^{\circ} 36'$ N., on the decl. arc of my Gurley solar compass and determine a meridian with the solar attachment which is in perfect adjustment. Further solar observations were taken along the line.

Thence

N. $0^{\circ} 21'$ W., on true line, bet. secs. 27 and 28.

40.10 To the $\frac{1}{4}$ sec. cor. determined from the original bearing trees.

Set an iron pipe 3 ft. long $1\frac{1}{2}$ ins. diam., 28 ins. in the ground, mkd. RS404, from which the original bearing trees:

A fir snag 38 ins. diam., bears N. 64° E., 47 lks. dist., mkd. BT

A fir snag 40 ins. diam., bears N. 37° W., 50 lks. dist., with scar, mks. burned out.

New bearing trees

A fir 18 ins. diam., bears N. 49° E., $6\frac{1}{2}$ lks. dist., mkd. $\frac{1}{4}$ S27 RS404 BT.

A fir 20 ins. diam., bears S. $13\frac{1}{2}^{\circ}$ W. 18 lks. dist., mkd. $\frac{1}{4}$ S28 RS404 BT. ✓

T. 26 S., R. 8 W.

Chains

Thence

N. 0° 17' E., beginning new measurement.

40.12 To the sc. cor. determined from the only extant bearing tree that can be identified, the other bearing trees are badly burned.

Set an iron pipe 3 ft. long 2 ins. diam., 28 ins. in the ground, mkd. RSL404: from which the only extant original bearing tree.

A fir snag 32 ins. diam., bears N. 43° E., 36 lks. dist., with partial scribe marks.

New bearing trees

A chinquapin 8 ins. diam., bears N. $8\frac{3}{4}^{\circ}$ E., 31 lks. dist., mkd. T26S R8W S22 RSL404 BT.

A fir 16 ins. diam., bears S. $55\frac{1}{4}^{\circ}$ E., 56 lks. dist., mkd. T26S R8W S27 RSL404 BT.

A fir 22 ins. diam., bears S. 15° W., 70 lks. dist., mkd. T26S R8W S28 RSL404 BT.

A chinquapin 9 ins. diam., bears N. $61\frac{3}{4}^{\circ}$ W., 43 lks. dist., mkd. T26S R8W S21 RSL404 BT.

I hereby certify that the bearings of all lines recorded in this survey were determined by solar observations and that the survey described in the foregoing field notes was executed in conformity with the laws of the State of Oregon.

Martin C. Moore

FILED
RECEIVED

AUG 21 1951

COUNTY SURVEYOR
DOUGLAS COUNTY, ORE.

51/41-1d