


FILED
RECEIVED

NOV 17 1959

COUNTY SURVEYOR
DOUGLAS COUNTY ORE.

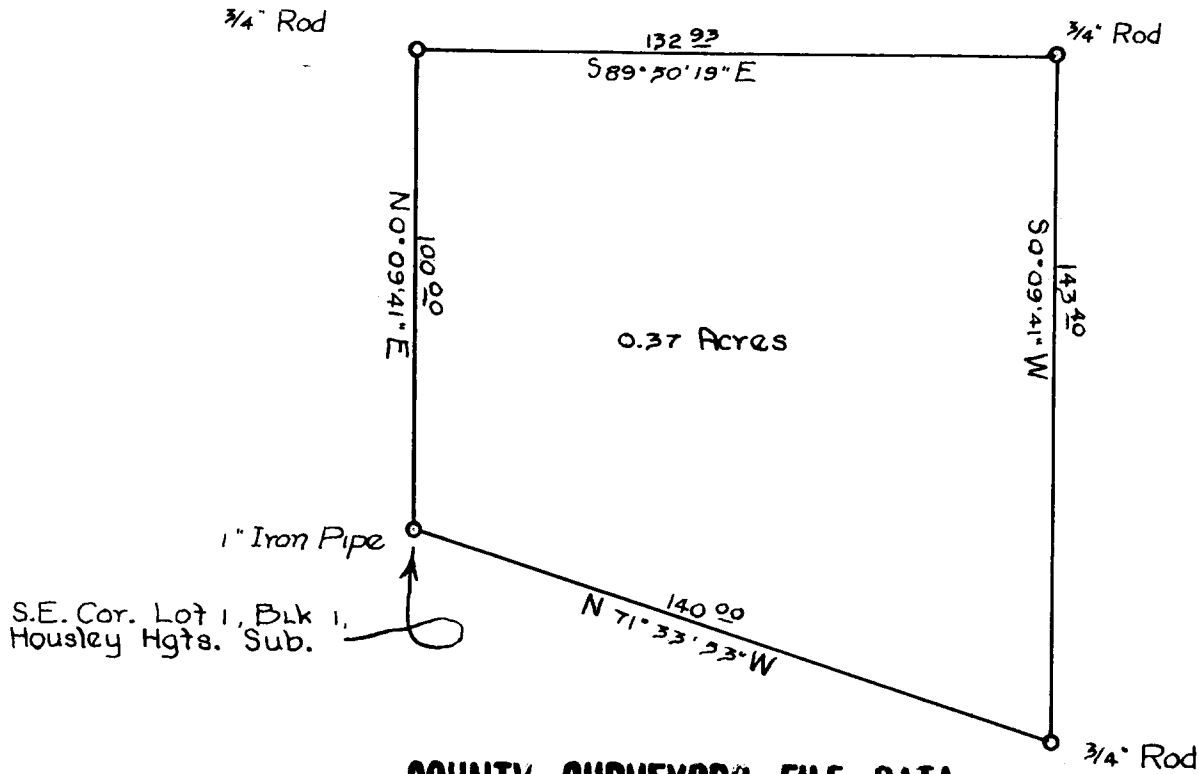

**COUNTY SURVEYORS FILE DATA
DO NOT REMOVE FROM OFFICE**

SURVEY FOR DEED DESCRIPTION

ISAAC JONES D. L. C. NO. 65

SECTION ¹³~~12~~, T. 27 S., R. 6 W., W. M.

DOUGLAS COUNTY, OREGON

Surveyed by R. H. Gee October, 1959
Scale 1" = 40'

R. H. Gee