



R. 12 W.

T. 22 S.

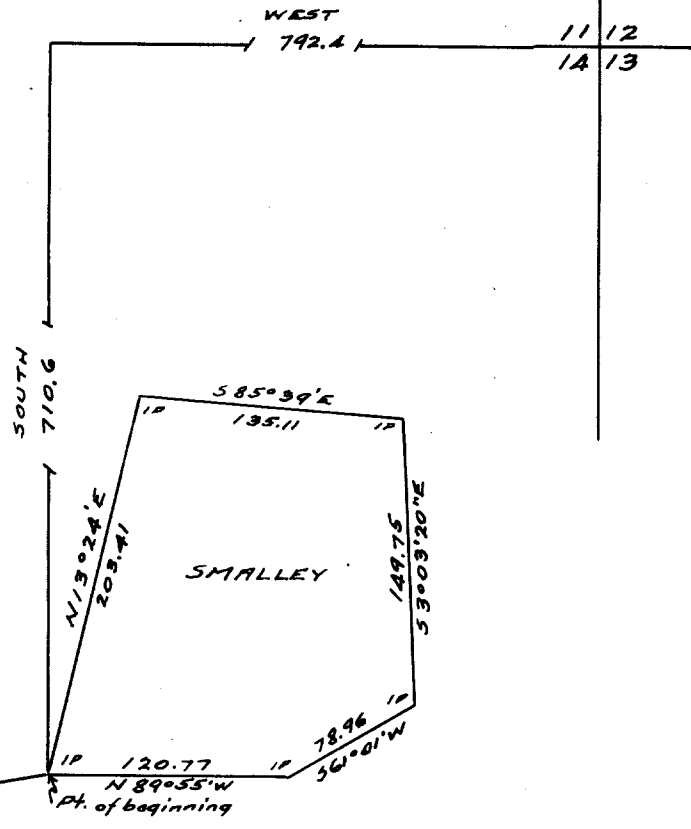

SCHUBERT
COUNTY
ROAD

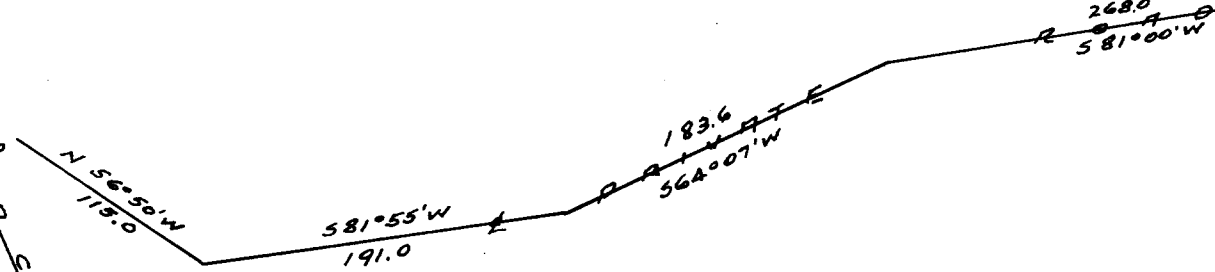

**COUNTY SURVEYORS FILE DATA
DO NOT REMOVE FROM OFFICE**

SURVEY
GEO. SMALLEY

SEC. 14, T. 22 S. R. 12 W. W. M.
DOUGLAS COUNTY
Scale 1" = 100' Feb. 1960.

FILED
RECEIVED

FEB 29 1960

COUNTY SURVEYOR
DOUGLAS COUNTY, ORE.

