

SURVEY & PLAT PREPARED FOR

P. M. GROW
MYRTLE CREEK, OREGON

SCALE: 1" = 20'

MAR 29 1960


COUNTY SURVEYOR
DOUGLAS COUNTY, ORE.

MARTIN ENGINEERING SERVICE - MYRTLE CREEK, OREGON



APRIL 1959

**COUNTY SURVEYORS FILE DATA
DO NOT REMOVE FROM OFFICE**

FILED *LL*
RECEIVED

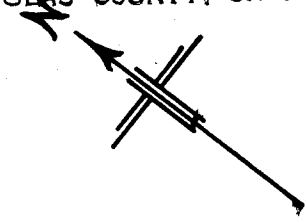

• SET NEW IRON PIPE & PINS

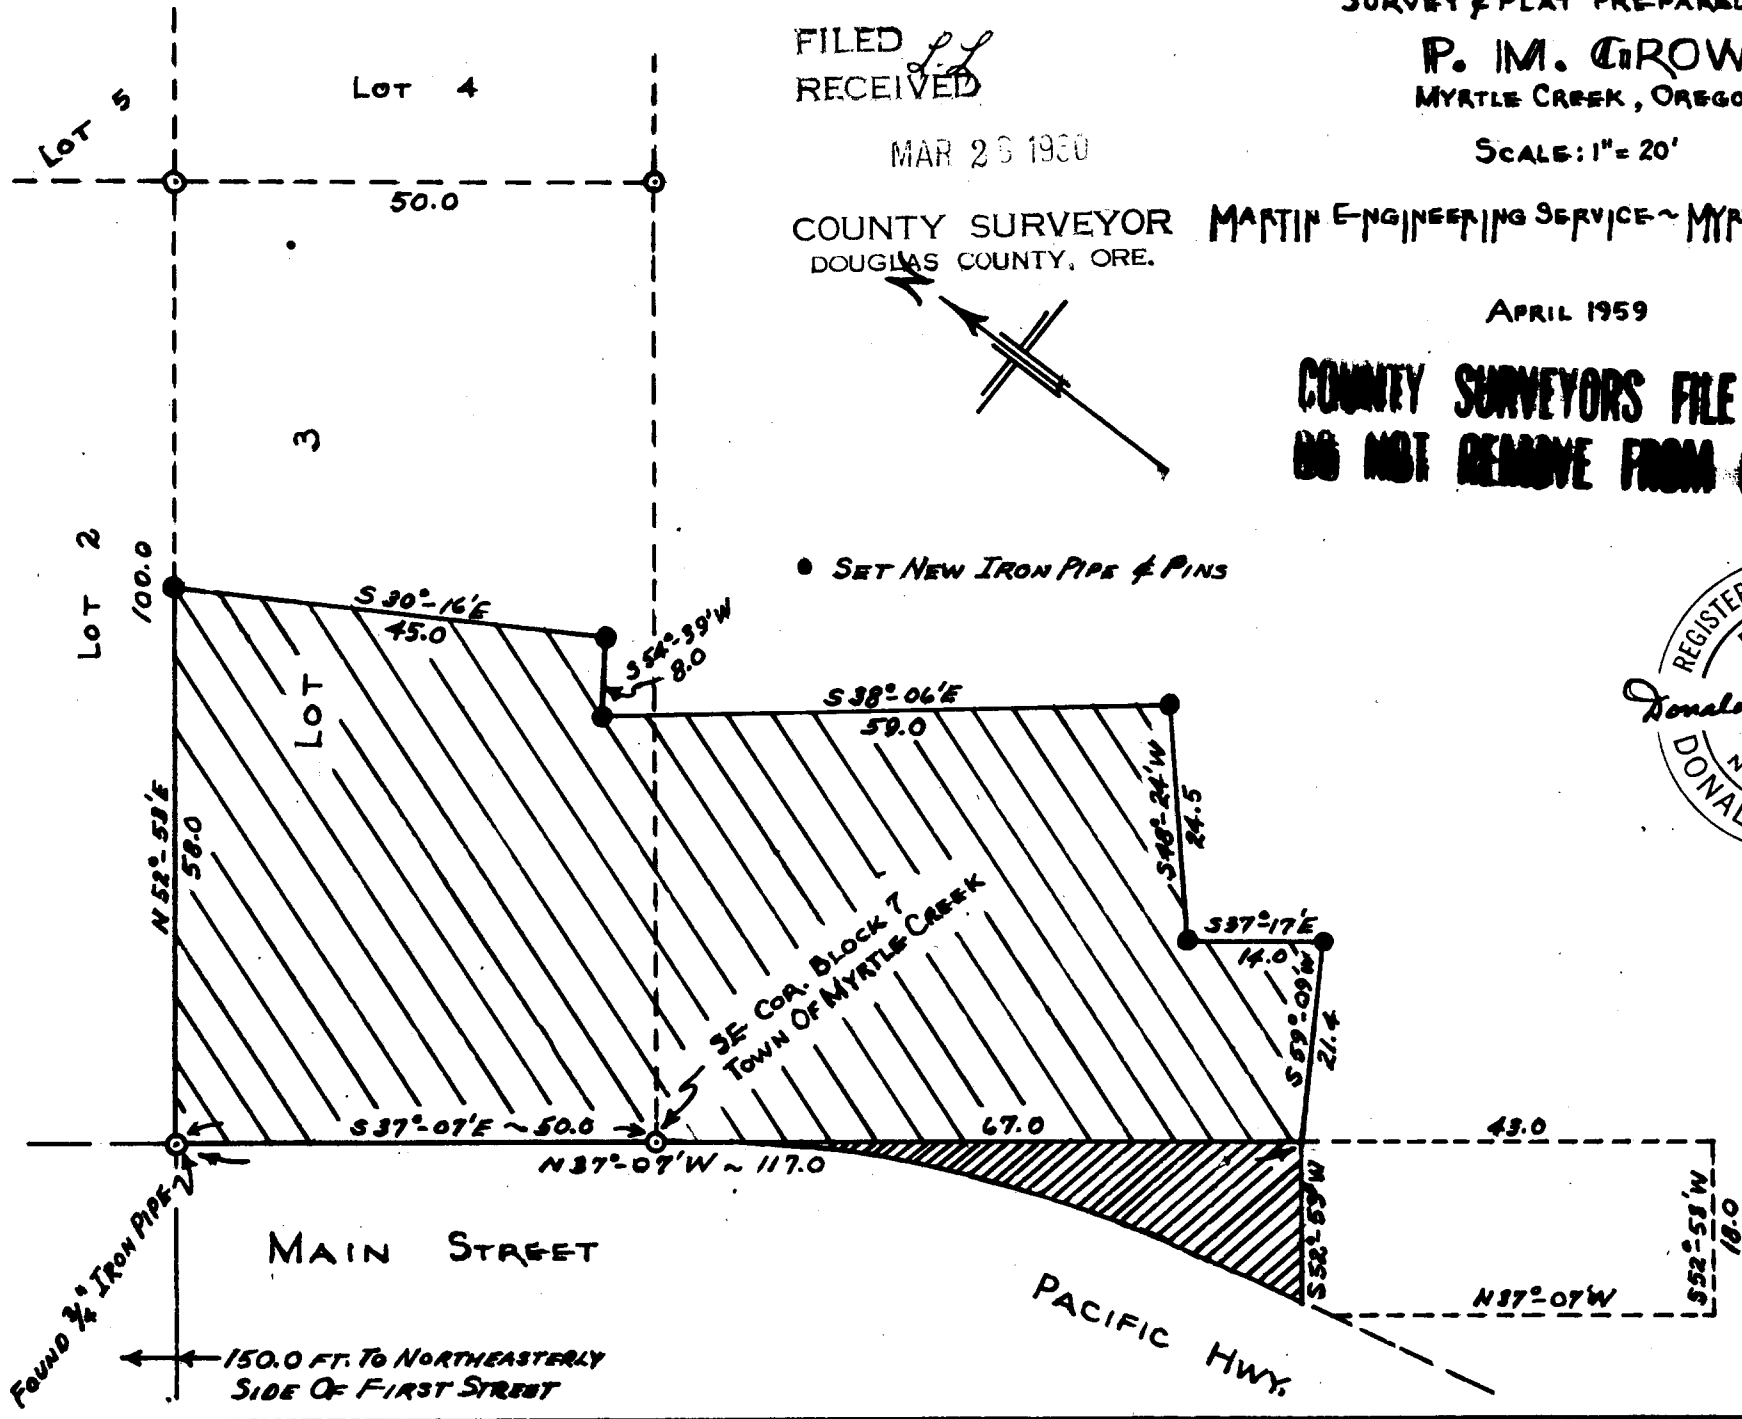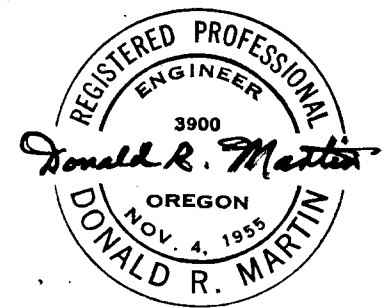

MAIN STREET

PACIFIC HWY.

150.0 FT. TO NORTHEASTERLY
SIDE OF FIRST STREET