

INITIAL POINT OF THIS SURVEY

FOUND IRON POSTS

S 26° 00' W
25.0


N 62° 00' W
178.0

N 62° 00' W ~ 1370.0 (DEED)

(DEED)
NO. 11
1851.5

S.E. CORNER
JAMES WEAVER
D.L.C. No. 37

• SET 3/4" IRON RODS

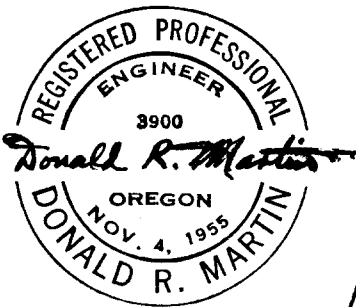

S 43° 44' W
405.1

2.5 ACRES

N 17° 52' 30" E
399.8

FILED
RECEIVED

MAR 20 1960

COUNTY SURVEYOR
DOUGLAS COUNTY, ORE.

COUNTY SURVEYORS FILE DATA
DO NOT REMOVE FROM OFFICE

S 65° 23' E
358.8

60 FT. ROAD RIGHT OF WAY

FIELD SURVEY & PLAT FOR
BRUCE WYNTER
MYRTLE CREEK, OREGON

SEC. 5 T30S R5W W.M. DOUGLAS COUNTY, ORE.

SCALE: 1 IN. = 50 FT.

JULY 1959

PRESBYTERIAN CHURCH PROPERTY

MARTINE ENGINEERING SERVICE ~ MYRTLE CREEK, ORE.

C. S. File No. 51/81-