

RESTORED CORNER FOR NATIONAL PLYWOOD, INC.

The section corner common to Sections 8, 9, 16, 17, Township 25 South, Range 1 West, W. M., Douglas County, Oregon.

The original surveyor thoroughly fouled up his recorded notes by mis-naming the bearing tree species and by giving wrong bearings, but the corner was finally reset from the two remaining bearing trees by observing the directions the scribes faced and by using the recorded distances for the two trees in their respective quadrants. The old blazed section lines also tie in with the restored corner.

ORIGINAL NOTES

(now missing)
A basalt stone, 18" x 10" x 8", with 4 notches on the south edge and the east edge, and from which stone as:

- 16" Fir bears N30°E, 7.9 ft. (Yew)
- 8" Cedar bears S59°E, 21.1 ft. (now missing)
- 5" Fir bears S14°W, 33.0 ft. (Cedar)
- 6" Fir bears N42°W, 13.9 ft. (now missing)


RESTORED CORNER

1/2 inch diameter brass rod
Set a ~~rod~~, from which as:

- 10" Yew, blown down, but with scribes visible and facing the corner, bears N77°E, 7.9 ft. (Original bearing tree.)
- 26" Cedar, scribes visible and facing the corner, bears S9°W, 33.0 ft. (Original bearing tree.)
- 58" Douglas Fir, newly scribed by me, "S 16 BT", bears S 88° E, 58.9 feet.
- 16" Douglas Fir, newly scribed by me, "T25S, R1W, S8, BT", bears N36°W, 30.7 feet.



Bruce A. Shaner

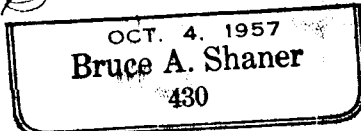

Variation of 20° E
February, 1960
Present & Witnessed by:

William James
William James

James B. Griffin
James B. Griffin

FILED
RECEIVED

APR 21 1960

COUNTY SURVEYOR
DOUGLAS COUNTY, ORE.