

Renewal of W.  $\frac{1}{4}$  cor Sec 19  
T27S R1E w M  
as determined by old B.T.

found 14" fir S39°E 52.8 ft - scribes  
and tree in good condition.


the 20" fir N47°E 44.2 ft was  
removed by Road Construction.

Replaced Gov't. Brass Cap which had  
been removed by road construction  
and marked new Bearing tree:

A 46" D. fir bears N14°E 80.2 ft  
to face of tree and marked  $\frac{1}{4}$  S19 Bt  
on the bark.

This Corner is in Road R/w clearing,  
approx. 30 ft. South of Cloburn  
Sale Road, and 50' North of E  $\frac{1}{4}$  cor  
of Sec. 24 T27S R1W w.n.

Witness +  
Carl Halverson

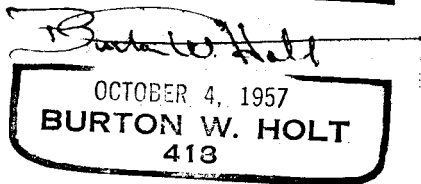

✓ ✓ ✓ C. S. File No. 51/100-1