

Renewal of E $\frac{1}{4}$ Cor. of Sec 24
T 27 S R 1 W W.M.
as determined by old BT's.

found 0 BT 32" fir S40°W 26.4 ft., scribes
and tree in good condition.

The 30" fir N59°W 14.5 ft was removed
in road construction.

found 22" fir S61°E 19.8 ft now a stump
with face where scribes were purposely
destroyed.

found line tree 13.2 ft North.


found old stone marked $\frac{1}{4}$ but the
brass cap and pipe are missing.

set $\frac{1}{2}$ x 36" iron rod with 1" square
nut at top for corner and set
new BT which is:


A 46" D. fir bears S72°W 29.8 ft to
face of tree, marked $\frac{1}{4}$ S 24 BT on the back.

This corner is approx 80 ft. south of
the Claburn Sale Road, and 50 ft so. of
W $\frac{1}{4}$ cor Sec 19 T27S

Witness: Carl Halverson

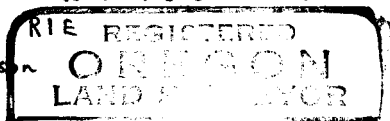

Burton W. Holt

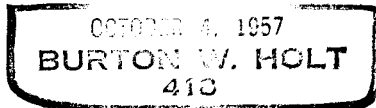

C. S. File No. 51/100-2