

CORNER ESTABLISHED


SECTION 12, T21S, R11W, W.M.

1. South one-quarter corner Section 12, T21S, R11W, W.M.

At a point midway on the south line of Section 12, T21S, R11W., W.M., the bearing and distance of which is 2643.8 feet South 85°57' East of the section corner for Sections 11, 12, 13, and 14, T21S, R11W, I set the south one-quarter corner. This corner is marked with a 1" x 45" gal. iron pipe 25" in the ground and surrounded by a mound of native stone. Two bearing trees were marked as follows:

A 22" crooked green Douglas Fir, bears N 43° 15' E 44 $\frac{6}{10}$ ft. to center of tree and is scribed: S-12 BT - on a face pointing toward the corner.

A 42" green Douglas Fir bears S 70° 30' W 74 $\frac{4}{10}$ ft. to center of tree and is scribed: S-13 BT - on face looking at the corner.

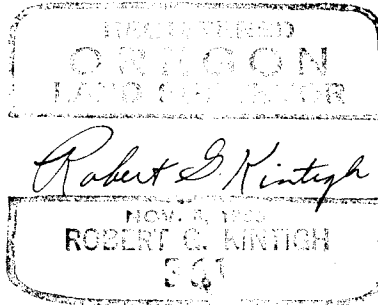

FILED
RECEIVED

JUL 1 1960

COUNTY SURVEYOR
DOUGLAS COUNTY, ORE.

D.S. No. 51/106