

Wilf Cor.


Found 30" tree marked for ^{HALL}A.W.P. ^{DINT} on the East line of Sect. 12 at 62.45 chs. This tree is now a stump; it apparently was 24" in diam. when scribed, it is now 32" inside the bark. There is an R. on the stump and the old scare goes down about 10"-12".

I found an S 7 on a log that came off the stump.


I drove a 1"x 1" x 24" T. iron about 12" in the center of the stump for A.W.P.

Cor.
Drove a 1/2"x 16" bolt in center of a 43" fir stump N. 21°W. 23.6 ft.

Drove a 1/2"x 5" lag screw in the center of a 54" fir stump N. 72°W. 34.6 ft.

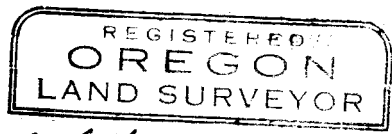

Wilford N. Haines

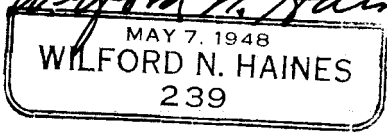

✓✓

CS 51/109-2