

Oct. 25, 1960

1/4 cor. 32/33 T305 R1W as
det. by O.B.T.

30" Cedar SSW 7.9' O.B.T. fd scribe
At cor. pt. set 2" x 36" Truck
axle with flange up

from which


6" Cedar SSE 22.6' 1/4 S 33 B.T.

16" La East 38.0' mkl. 1/4 S 33 B.T.

5" W. Fir N55E 39.0' 1/4 S 33 B.T.

50" Fir N8W 47.4' 1/4 S 32 B.T.

Witness: R.G. Boyd

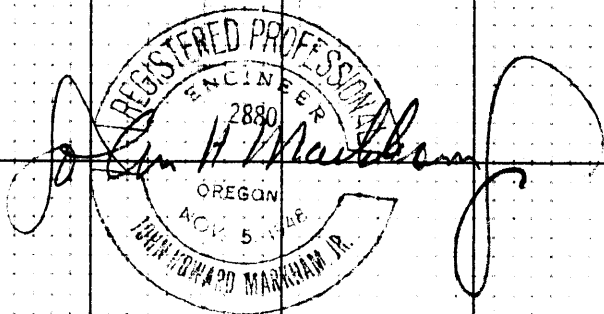

Work done for Stemon Lib. 51/121⁴
C.S. File No.