

Oct. 25, 1960

1/4 cor. 21/22 T305 R1W

At a point 214.5' South
of W.C. 21/22 I set a
point which falls in Jackson
Creek


from which

15" Fir bears N70W 47.0'
dist. mkd. '14521 B.T.

22" Cedar bears S88E 70.0'
dist. mkd. '14522 B.T.

Jackson Creek Road bears
East 95.0'

Witness: R.G. Boyd

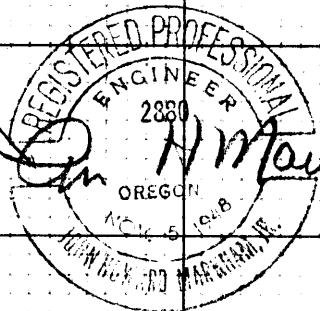

[Handwritten Signature]

Work done for *[Handwritten Name]* Co. C. S. File No. 51/121¹⁶