

**COUNTY SURVEYORS FILE DATA
DO NOT REMOVE FROM OFFICE**

**SURVEY FOR DEED DESCRIPTION
IN LOT 2, SEC. 17, T. 26 S., R. 3 W., W.M.**


SURVEYED FOR: HELEN GLENN

OCTOBER, 1960

SURVEYED BY: G. R. LECKLIDER - ENGINEER

SCALE: 1" = 80'

o Denotes Steel Tube with Survey Cap Set

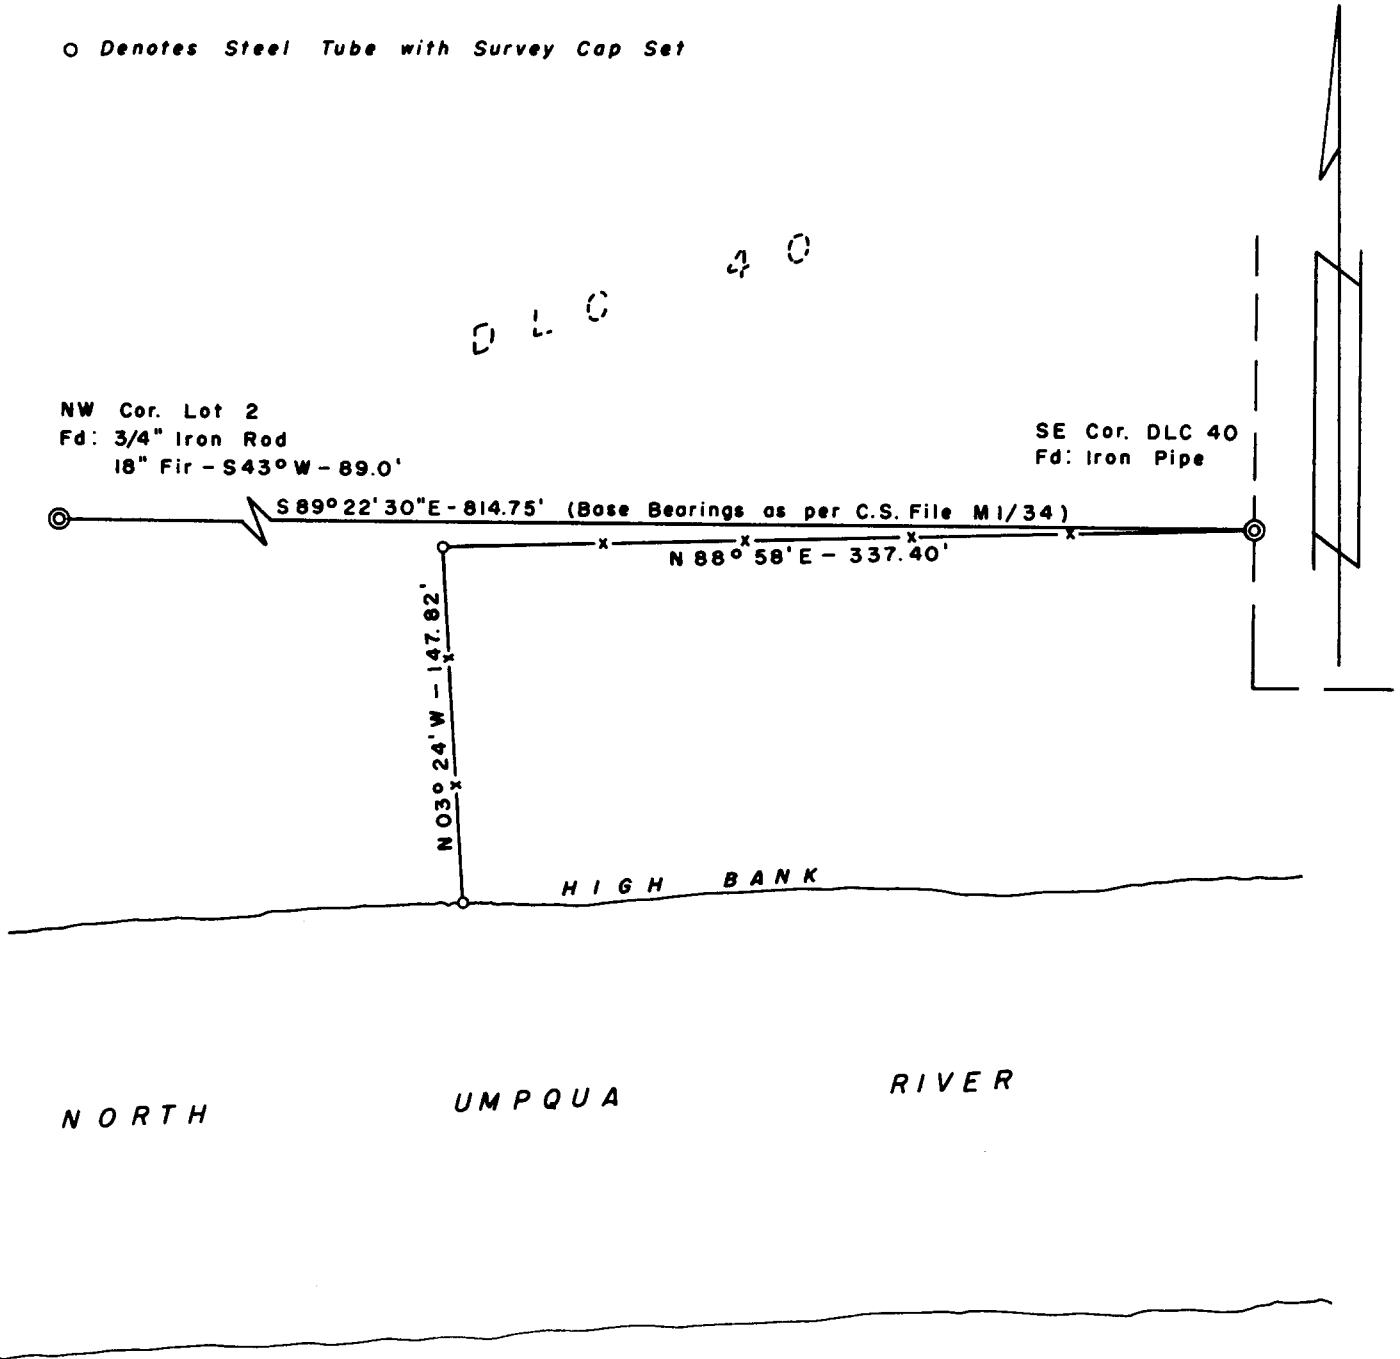

FILED
RECEIVED

OCT 1 1960

COUNTY SURVEYOR
DOUGLAS COUNTY, ORE.

