


COUNTY SURVEYORS FILE DATA
DO NOT REMOVE FROM OFFICE

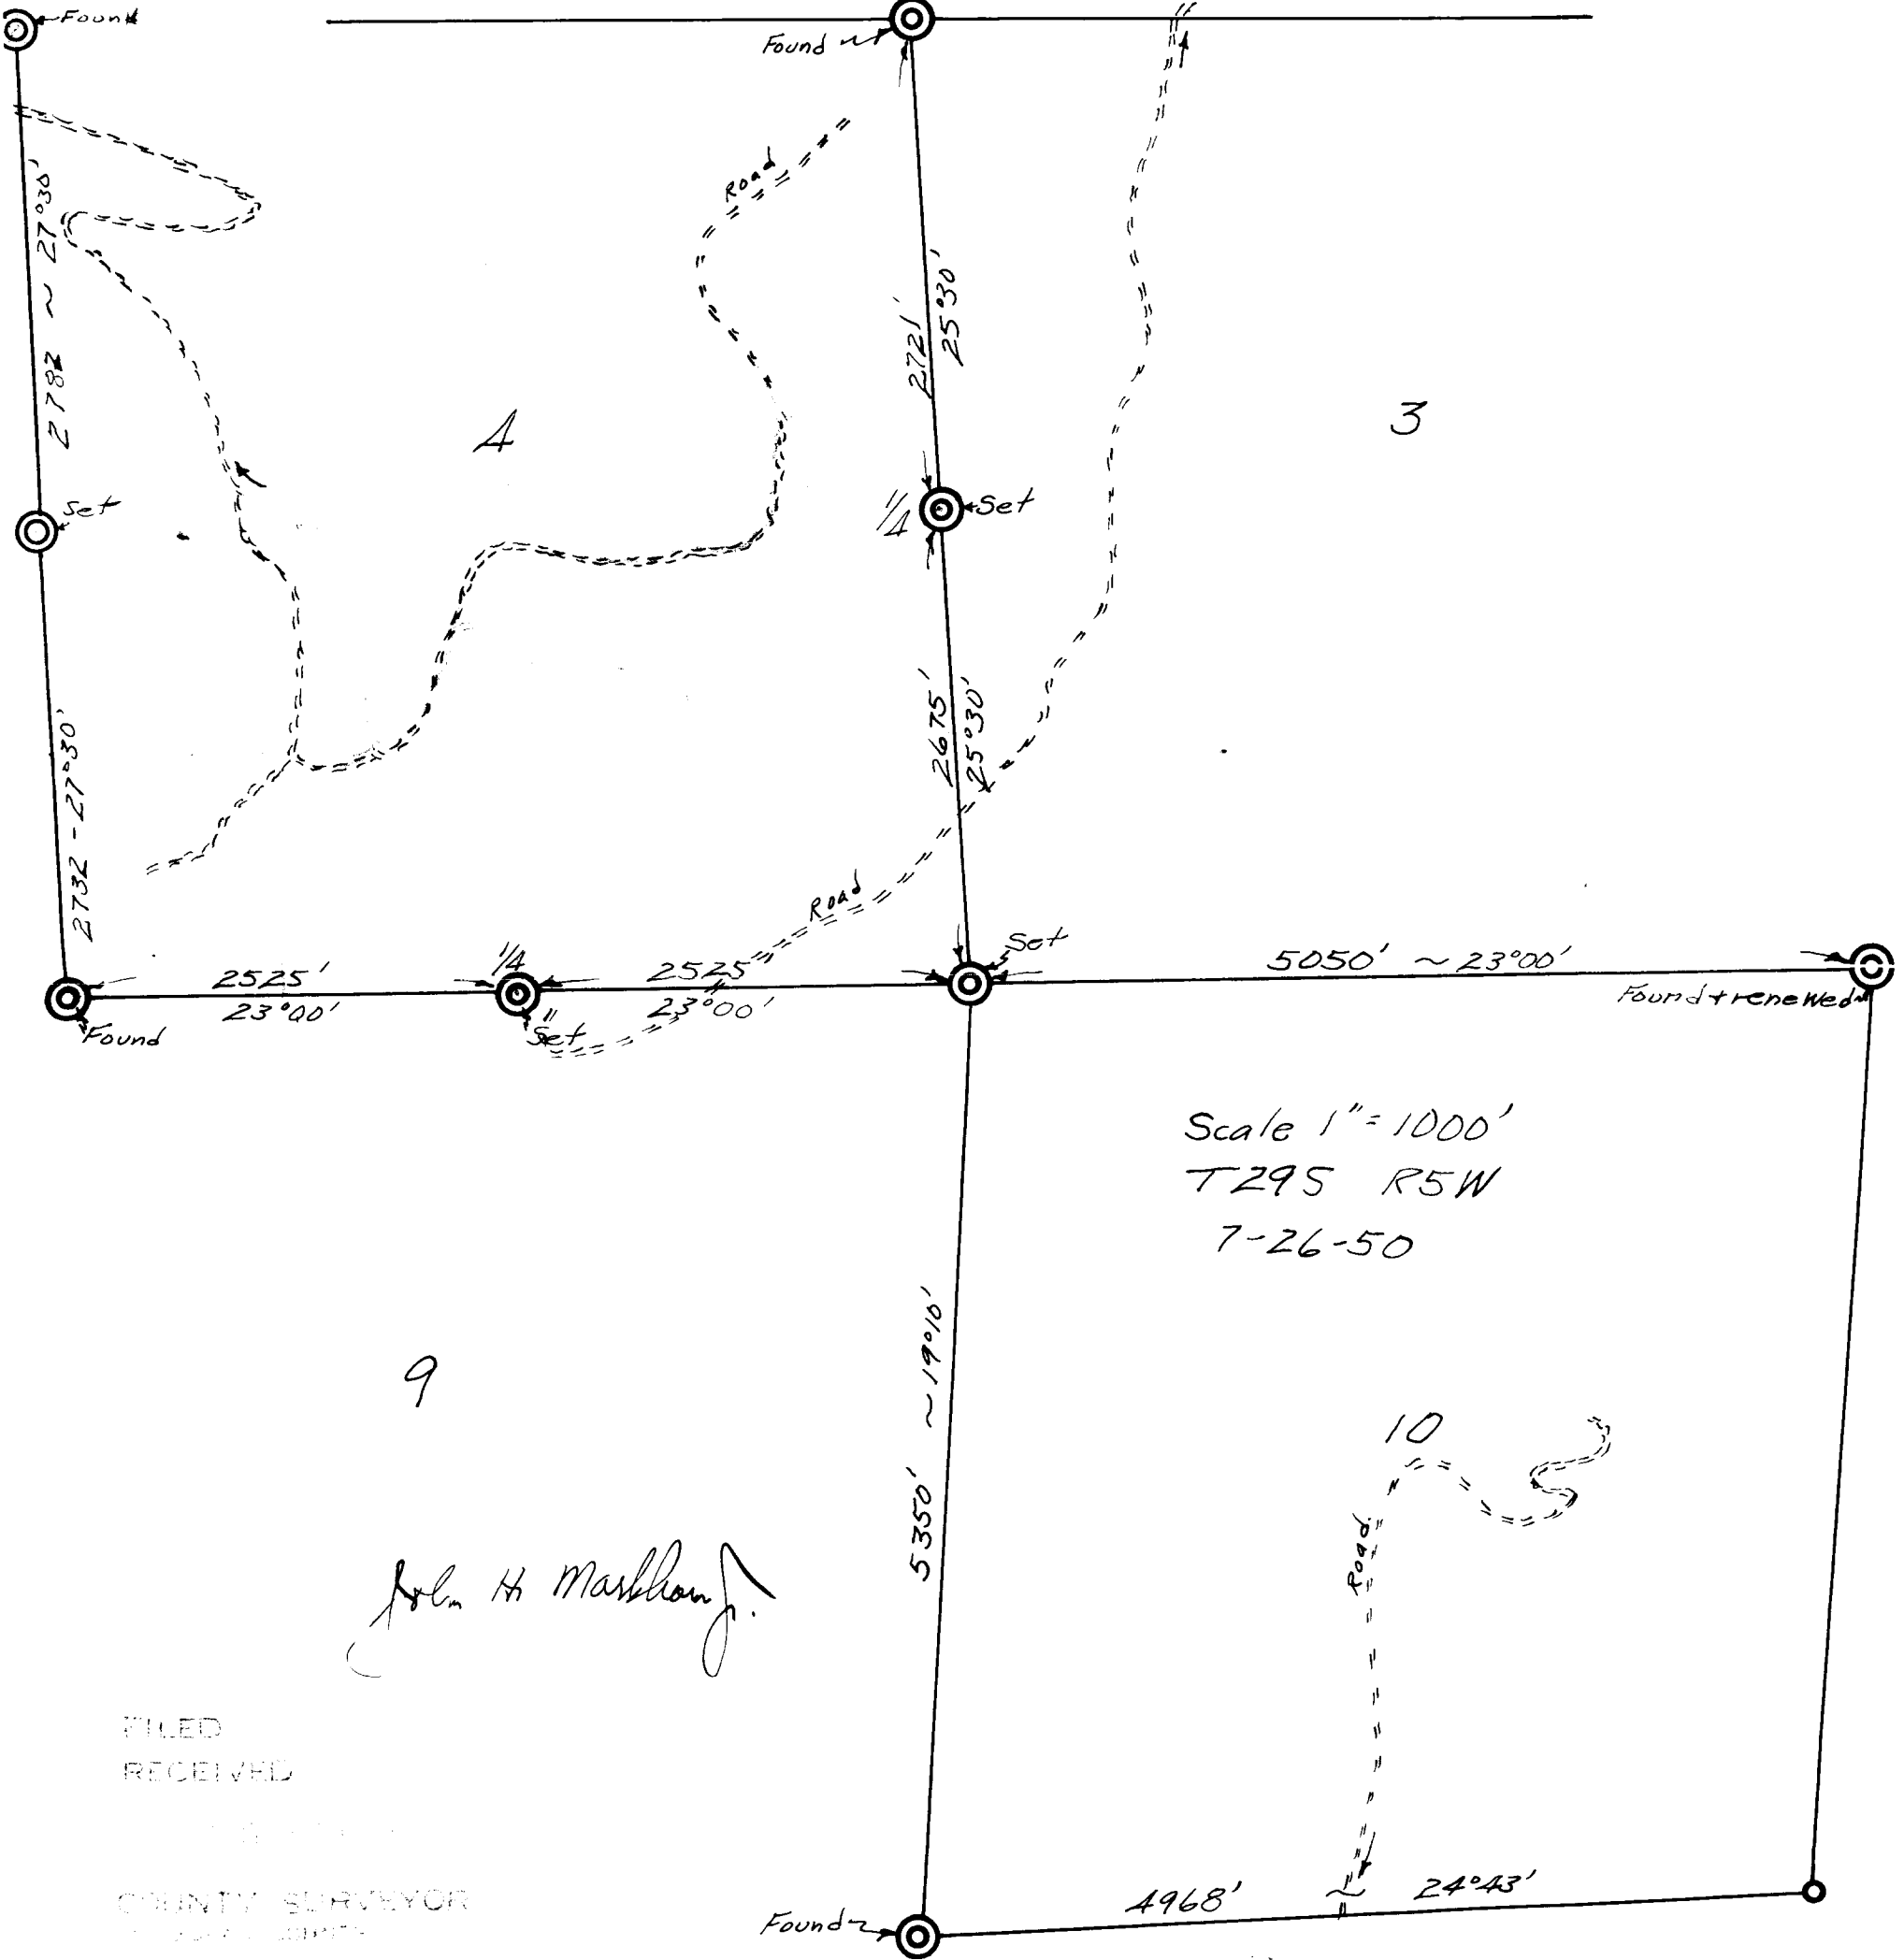

Scale 1" = 1000'
T29S R5W
7-26-50

John H. Markham Jr.

FILED
RECEIVED
COUNTY SURVEYOR

51/130-24