


COUNTY SURVEYORS FILE DATA
DO NOT REMOVE FROM OFFICE

Prepared for
MYLES N. JONES
Scale 1" = 200' Nov. 1951.

Project:
Date:
County:
Township:
Range:

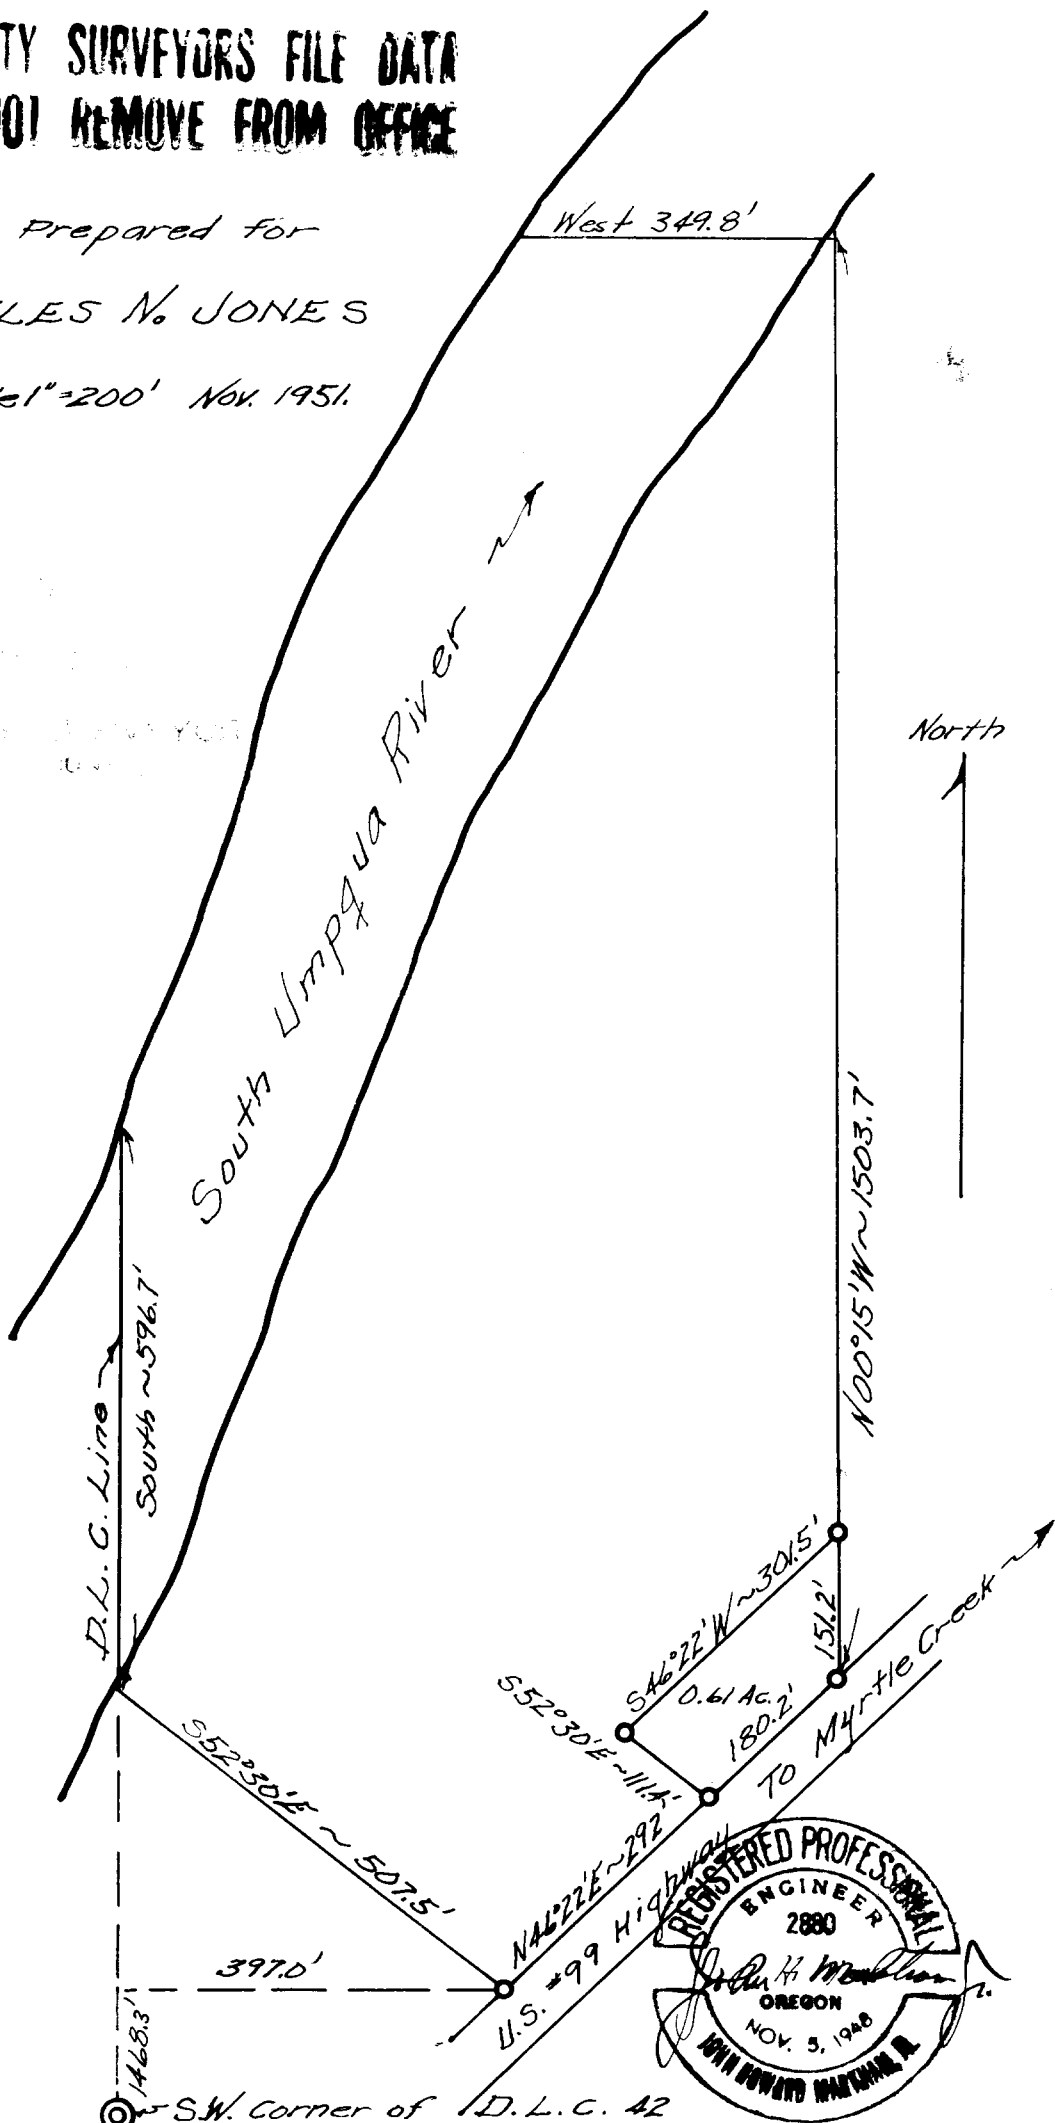

SW. corner of D.L.C. 42
T29S, R5W, N.N.