


COUNTY SURVEYORS FILE DATA
DO NOT REMOVE FROM OFFICE

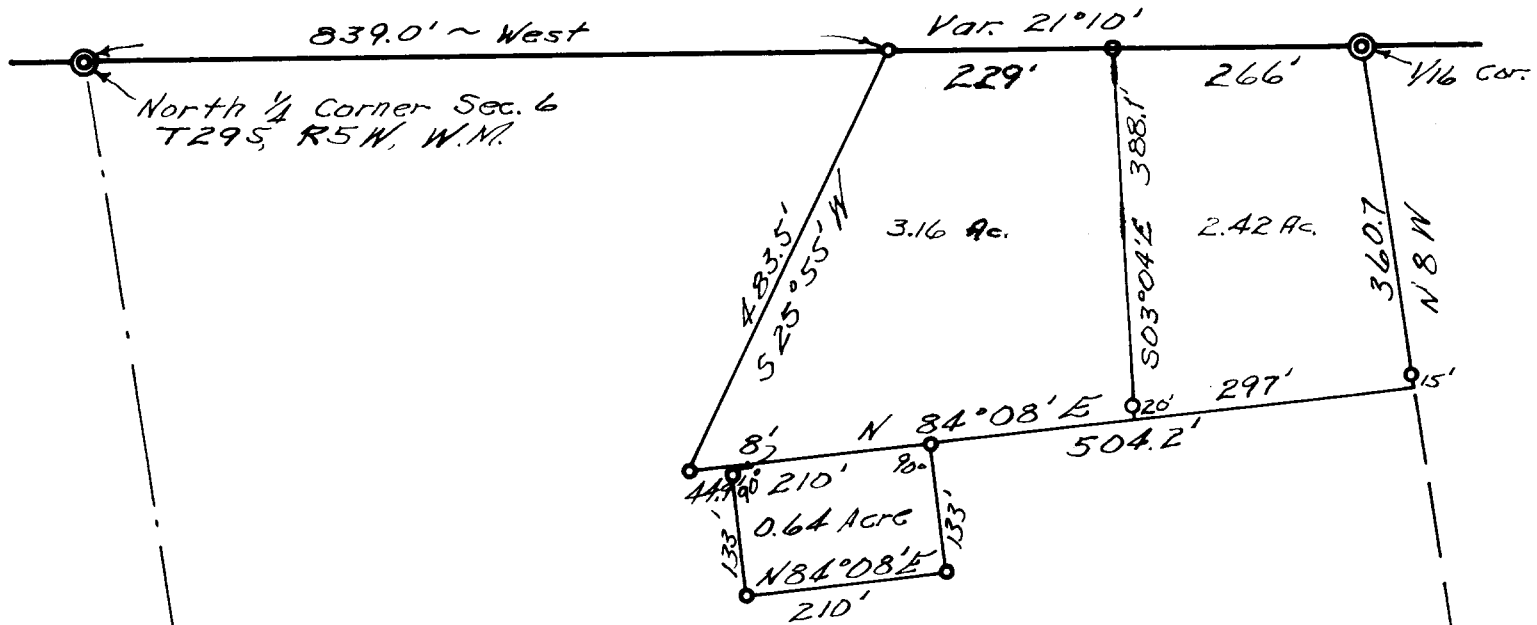

Prepared for
Mrs. T. B. Richardson
Showing Lot 2 (NW 1/4 NE 1/4) Sec. 6, T29S, R5W, W.M.
Scale 1" = 200' Oct. 1952.

