

PREPARED FOR


T.W. ALLEN

COUNTY SURVEYORS
CLATSOP COUNTY

PORTION OF D.L.C. 43 T30S, R4W.

SCALE 1" = 200'

JULY 1949

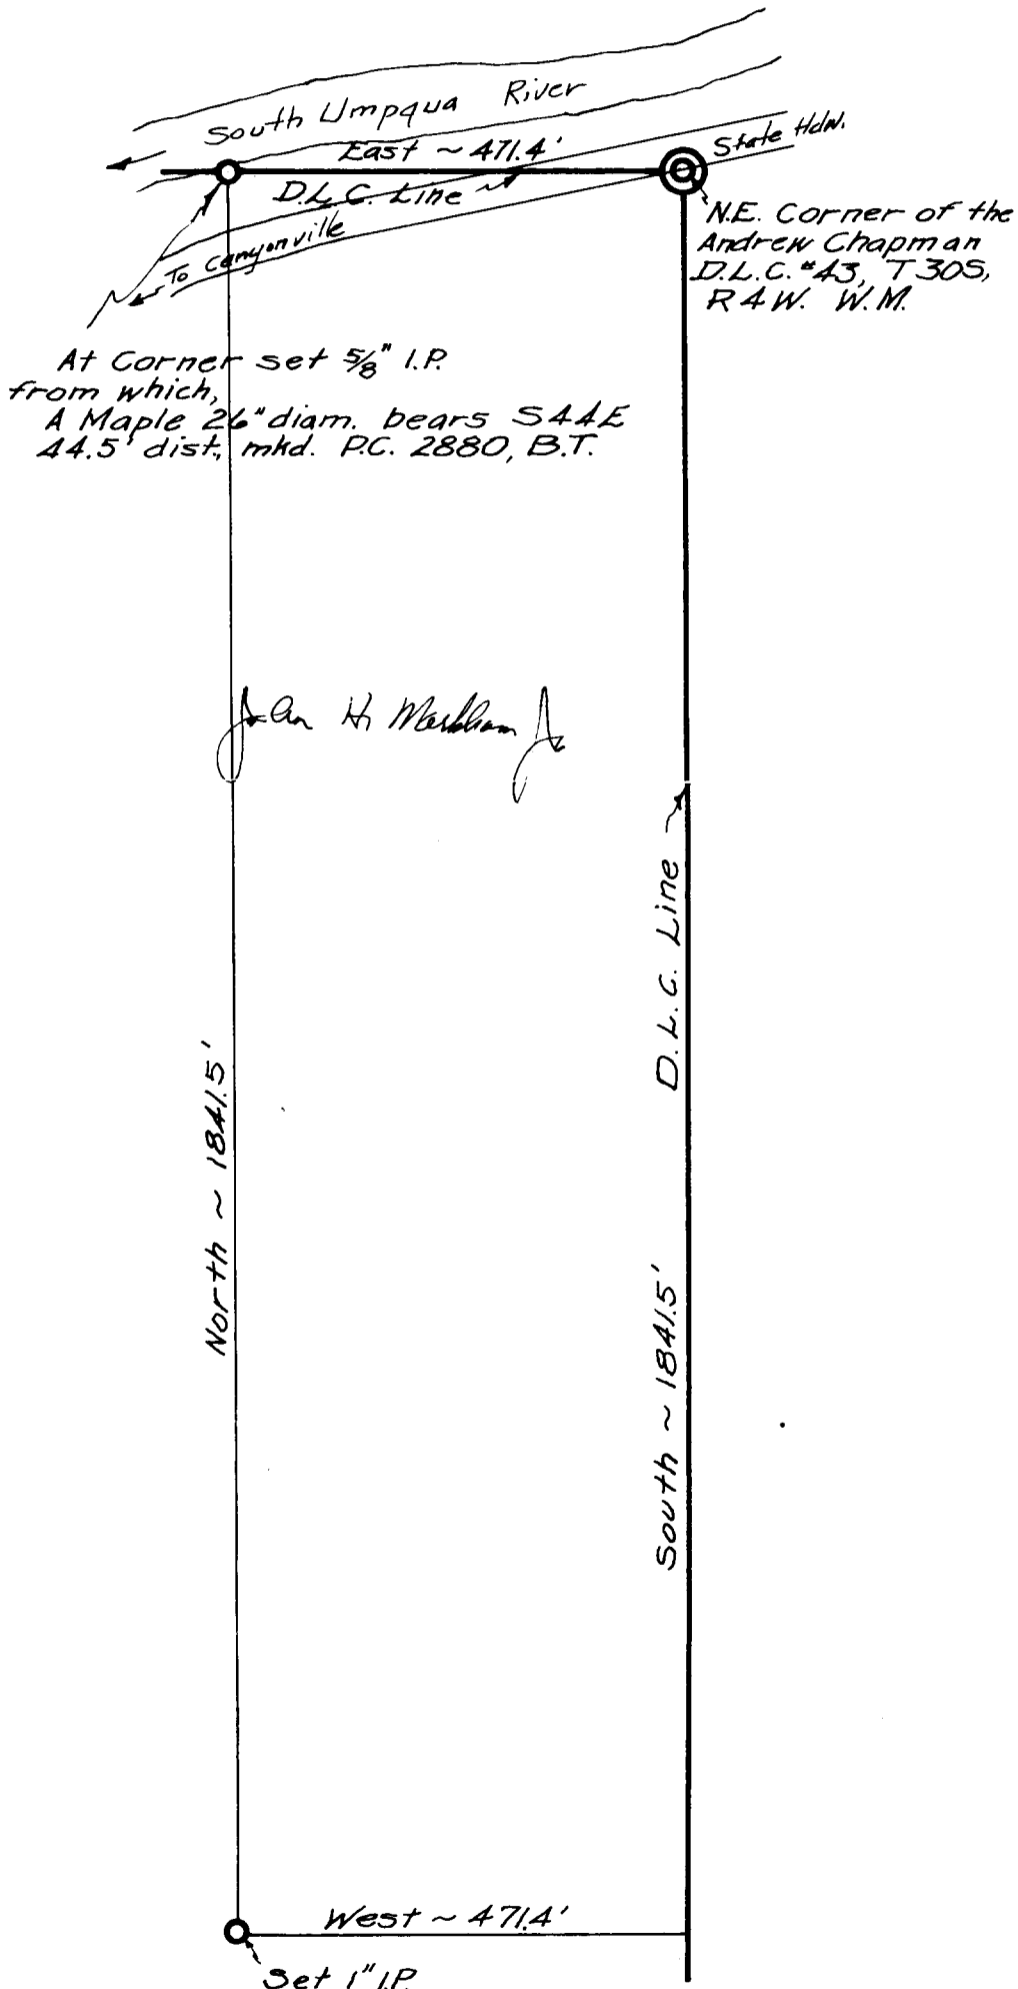

COUNTY SURVEYORS FILE DATA
DO NOT REMOVE FROM OFFICE

51/131-1